25th St. Adams to Jefferson. Curb line proposed ~~23~~ 22. ft. from N. side. & ~~26½~~ 27.5 ft from center of street 20. to 21. ft. from present fence & clears trees 1. ft. curb line proposed ~~17~~ 16. ft. from S. side – ~~31.5~~ ~~32.5~~ 23.5 ft. from center line 2. ft. beyond F. J. Kiesel's curbing – this leaves ~~59.0~~ ~~58~~ 60. 61.0 ft. clear road-way bet. curbs.
adopted by City Council. June 15-1903.

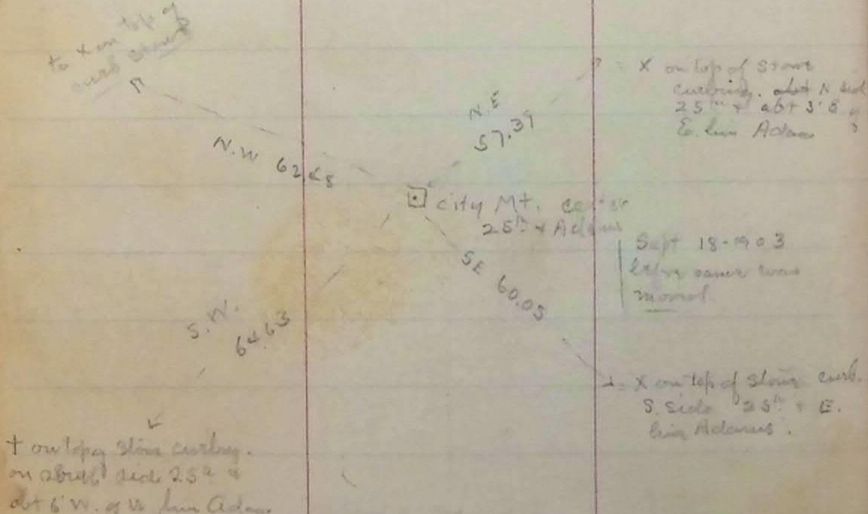

Rate of Grade – N. Curb from Sta 108+11.98 to Sta 110+89.28
Rate = 4.51676 +
" " " N. curb from Sta 110+89.28 to Sta 114+90.83 Rate = 1.36546.

Rate on S. curb,
from Sta. 108+11.98 to Sta 110+75 Rate = 4.51676
" " 110+75 to " 114+90.83 " 1.36546

Elevations for Curbing & Guttering
Dist. No 1-
25th Street – Bet. Adams and Jefferson

North Curb	Gutter							Station							Gutter	South Curb
	6	11	16	21	26	30			30	26	21	16	11	6		
								~~Sta 107+76.48~~ center line Adams Ave								
4360.137								Sta 108+03.98 {East Curb line Adams Ave.}								4361.389
4361.30								Sta 108+11.98								4361.750
4361.932	61.26	61.66	61.94	62.16	62.32	62.43	62.485	Sta 108+25.98 East Line Adams Ave.	62.485	62.50	62.46	62.37	62.23	62.03	61.71	4362.382
4363.017	62.35	62.75	63.03	63.25	63.41	63.52	63.57	Sta 108+50	63.57	63.59	63.55	63.46	63.32	63.11	62.80	4363.407
4364.146	63.67	63.87	64.15	64.37	64.53	64.66	64.69	Sta 108+75	64.69	64.71	64.67	64.58	64.44	64.23	63.93	4364.896