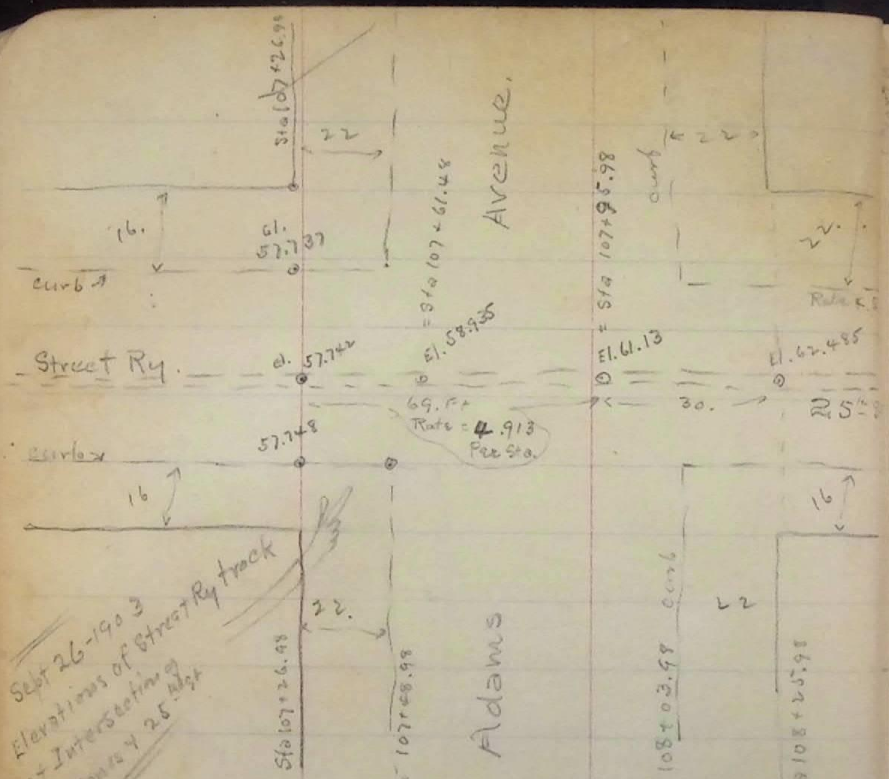

43.77.508 B.M. sand stone cor. on west side of Butler Ave near station 110+85

Change in rate of grade at Sta 110+81.28

Elev. 48.73.825

Note - On Cross-walk on E. side 25th St, the East curl of Adams Curve is 4.7 ft. W. of Property line

25th St. East Adams & Jeff.

43.72.921											
70.25											
70.65											
70.93											
71.15											
71.31											
71.42											
71.47											
Sta 110+25											
71.47											
71.49											
71.45											
71.36											
71.22											
71.01											
70.79											
43.72.501											
71.83											
Sta 110+50											
72.60											
72.62											
72.58											
72.49											
72.35											
72.14											
72.46											
43.72.071											
73.80											
Sta 110+75											
73.73	74.15	73.5	73.30	43.73.971							
73.75	74.13		72.51								
73.71	74.06		72.11								
73.62	73.93		73.41								
73.48	73.15		72.57								
73.27	74.13		73.68								
73.23	74.15		73.73								
73.30	74.15										
73.27	74.13										
73.20	74.06										
73.07	73.93										
73.90	73.15										
73.66	73.31										
73.44	73.15										
73.30											
Sta 111											
74.64											
74.62											
74.55											
74.42											
74.22											
74.02											
73.44											
73.30											
Sta 111+25											