24th bet Washington & Adams

Curb line N. side of Street

= 102 + 46.0 = round Cor

West Driveway into Weber & Courthouse grounds

= 102 + 60.3 = round Cor

BM. 4324.821 x on W. end Stone Step (1st Step from bottom) at W. entrance to Perry Block S. side 24th St. at Sta 102+45

BM 4326.832 on cap of Stone at S.W. cor. Courthouse lot about Sta 102+60

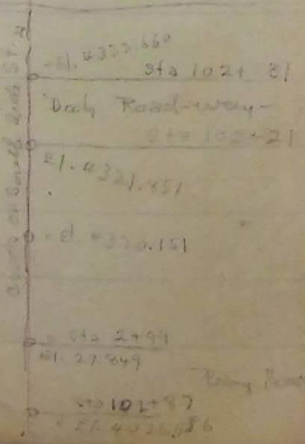

					4319.289	North Curb Gutter			
						10.62			
						19.02	Cour		
						15.31	11		
						16.55	16		
						19.25	21		
						19.80	26		
						20.01	31		
						20.05	33.5		
					Sta	102		20.05	335
								20.07	31
								20.08	26
								20.07	21
								20.07	16
								11.89	11
								17.23	16
								18.48	
					4321.197		20.94		
					Sta	102+25			
					4323.105		22.43		
							22.85		
							23.16		
							23.42		
							23.64		
							23.81		
							23.93		
							23.98		
					Sta	102+50			
								23.98	
								24.01	
								24.03	
								24.04	
								23.97	
								23.90	
								23.77	
								23.93	
					4325.012		24.76		
					Sta	102+75			
					4326.940		26.25		
							26.67		
							26.99		
							27.22		
							27.42		
							27.59		
							27.71		
							27.75		
					Sta	103			
								27.75	
								27.75	
								27.81	
								27.80	
								27.74	
								27.69	
								27.49	
								27.28	
					4327.635		4326.063	4324.200	4322.151 Sewer