

Note

24<sup>th</sup> St. Adams to Jefferson.

Curb line proposed 20ft from N. side - 29<sup>5</sup>/<sub>10</sub> ft from center line of street - 20 ft from proposed fence line clears trees 1 ft.


Curb line proposed 18 ft from S. side 31.5 ft from center line 18 ft from proposed fence line leaves 61 ft clear roadway bet curbs. 11 ft from rails.

approved by City Council June 15-1903.

Rate of grade for curbs, bet Adams + Jefferson

= 1.84418 per sta. From 108+03.98 to Sta 113  
Rate = 1.2205 " " From 113 to Sta 115+04

+ on top of stone curbs.

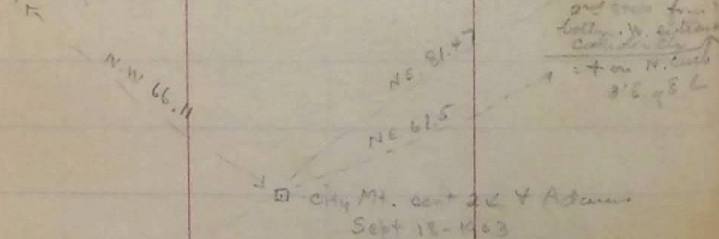

S.E. Cor. of base  
Sta. at S.W. cor  
Adams + 24 St  
The stone on which  
the upper row rests.

Note! 2 rows of offset Nails are set 50' apart on each side of center of 24<sup>th</sup> Str. bet Adams + Jefferson  
The row on the S. side is set 42.5 ft from center  
" " N. side 37.5 ft from center

24<sup>th</sup> bet Adams + Jefferson.  
Gutter  
6  
16  
21  
978