Intersection 24th St. & Lincoln
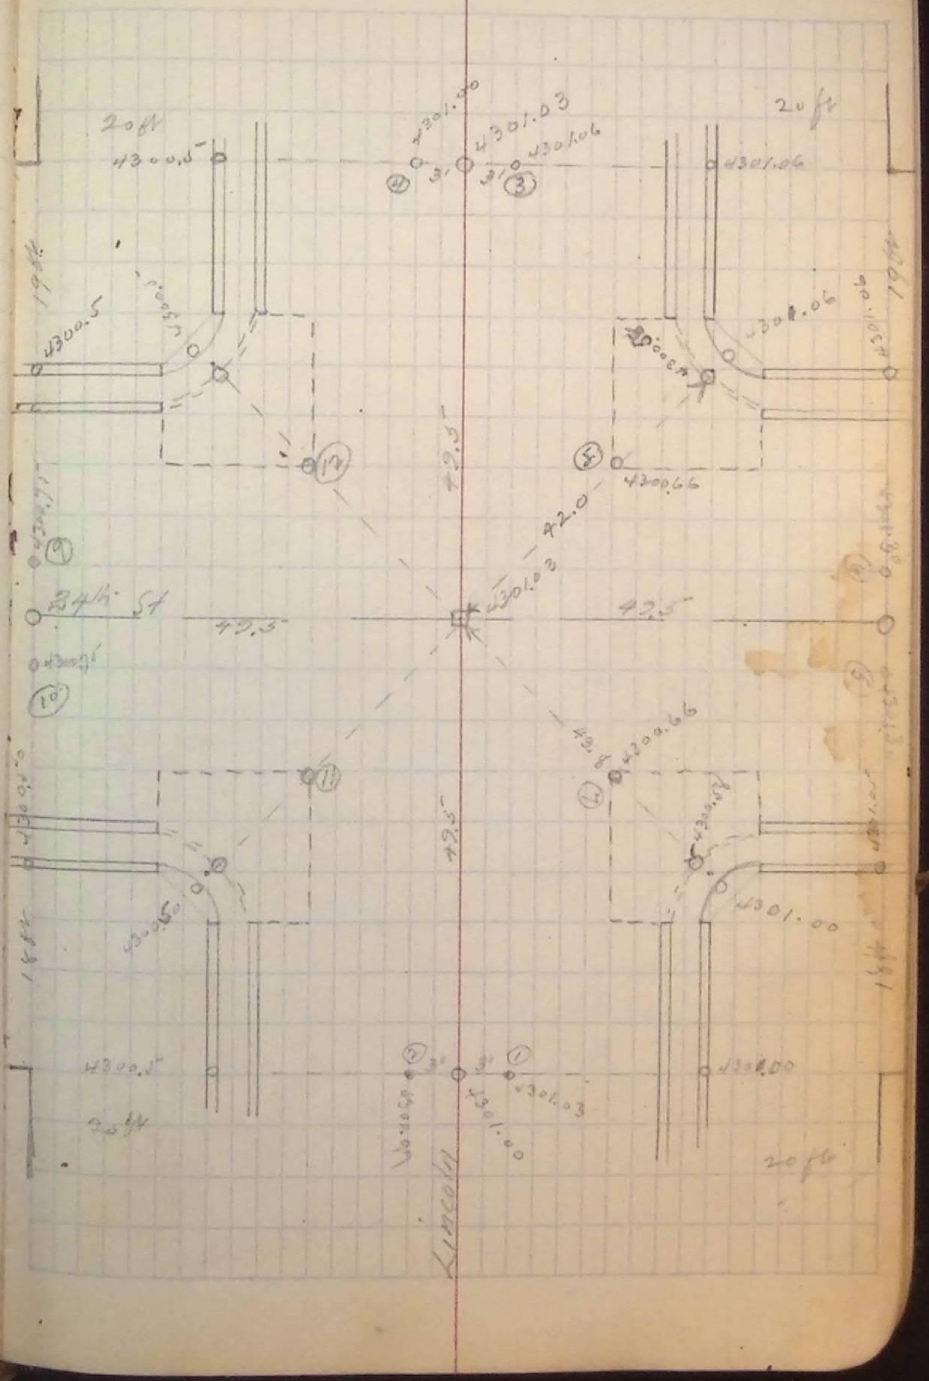
Mon B.M.	4.50	4305.38	4300.88	
#1			4.35	4301.03
#2			4.41	4300.97
#3			4.32	4301.06
#4			4.38	4301.00
#5			4.08	4301.30
#6			4.08	4301.30
#7			4.72	4300.66
#8			4.72	4300.66
#9			4.63	4300.75
#10			4.63	4300.75
#11				
#12