


Location of Fences
 on E and W Side Fowler Ave
 bet. 25th St. and 26th St.

25th

379.5

Street 1919

379.5

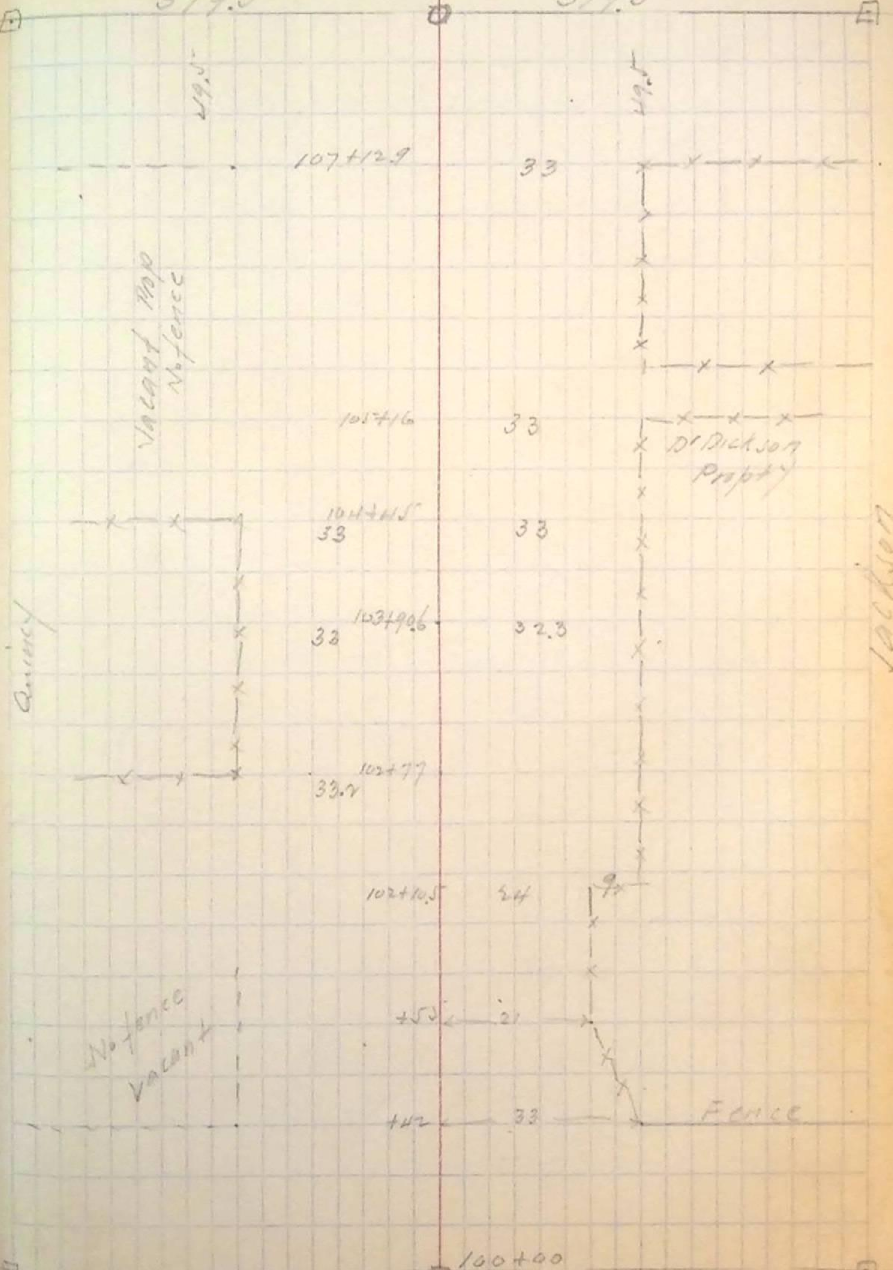

379.5
 26th

Street
 379.5