


Location of Center Line Canon Road
from Sta 6 "Sec pg 37" to intersection
of 12th St near Power House

#	Angle	Course	Dist. Ft	Dist Chs.	
# 5	$37^{\circ}10' R$	$S 87^{\circ}20' E$	878.96	12.52	
# 6	$8^{\circ} L$	$N. 84^{\circ}40' E$	571.36	8.96	Hut
# 7	$27^{\circ}16' L$	$N. 57^{\circ}10' E$	1119.36	15.96	
# 8	$4^{\circ}30' R$		288 ^L		Iron Bolt
			390.		
# 9	$14^{\circ}15' L$		228		Iron Bolt
# 10	$9^{\circ}53' R$		1542	67.0 ^L 90	

Tie to #10 ^{NW} 22.5' to S & Gt House
SE. 23.5' to NW " Nookin Mill

(from page 37)

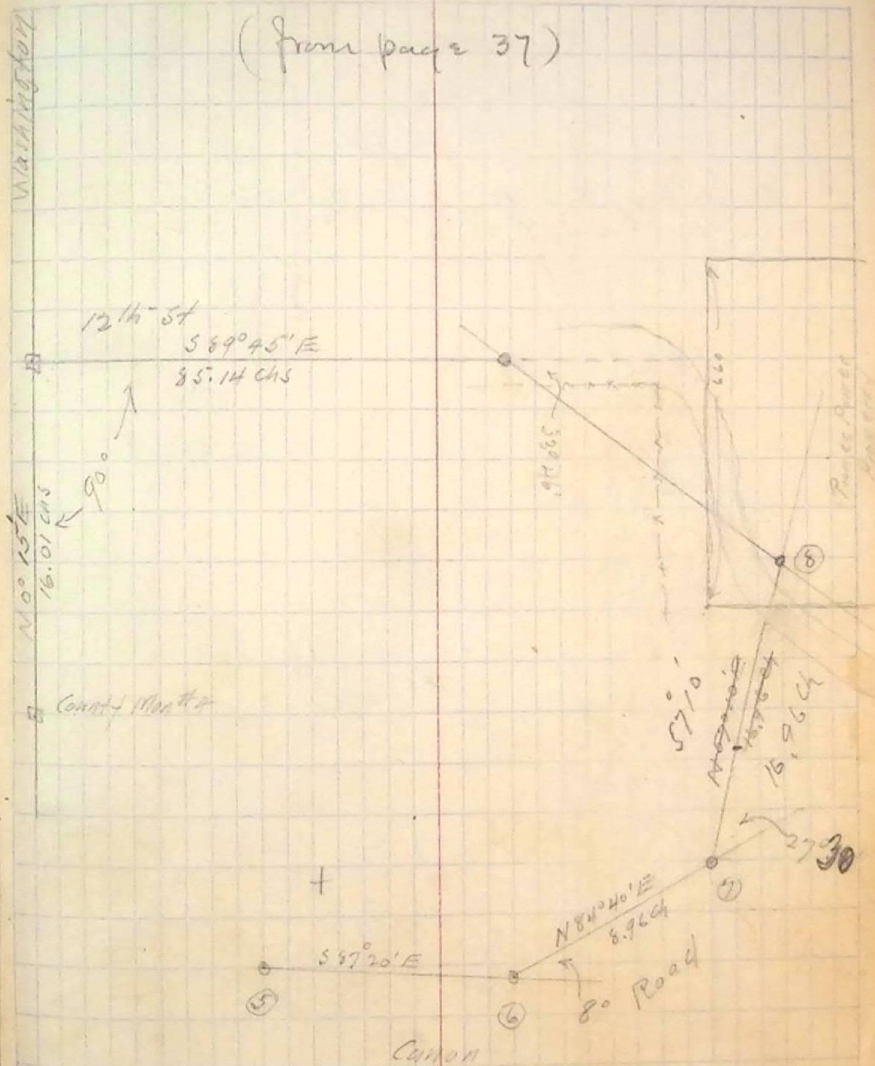

Lat 2

Long - Stone H.

Long - Stone H.

Time 10

Fri

Sat

25

10

10