

Mar. 23 1905


Survey to locate a new position of
Fire Hydrant at N.E. cor. 24th & Quincy

Q.K.P. Int.

A.D.G. chain } 1 P.M. to 5 P.M.


H.B.S. chain }

2 hours on hydrant & 2 hours checking out on
Quincy

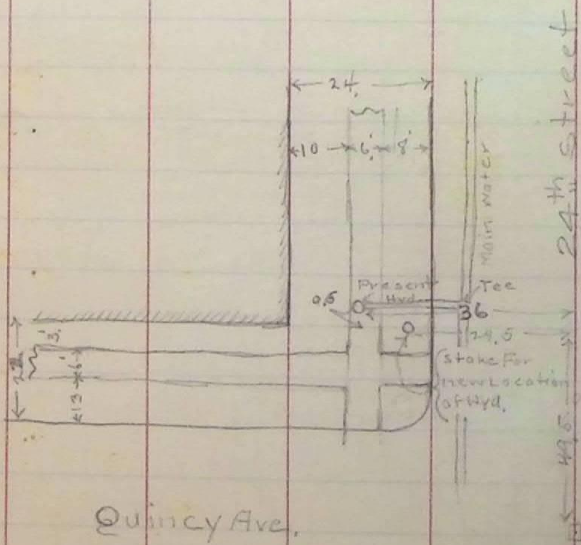

Quincy Ave.

24th Street

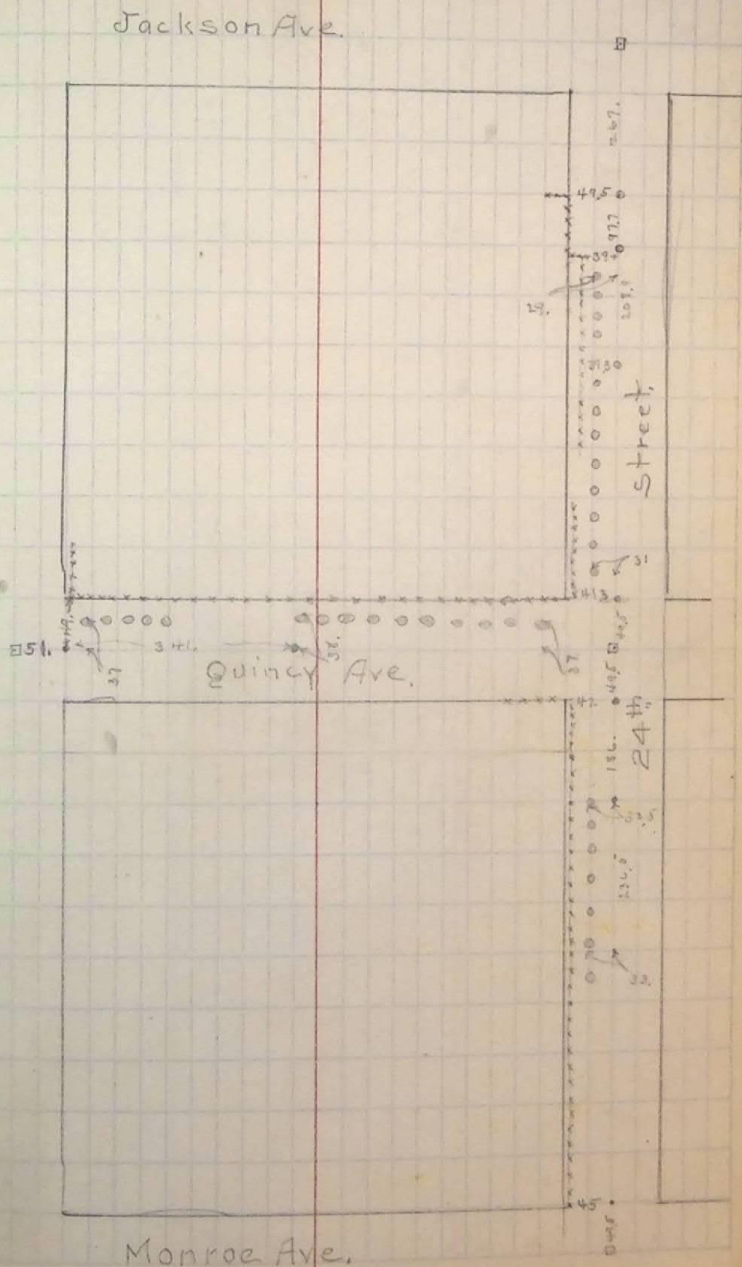

Jackson Ave.

Quincy Ave.

24th Street

Monroe Ave.