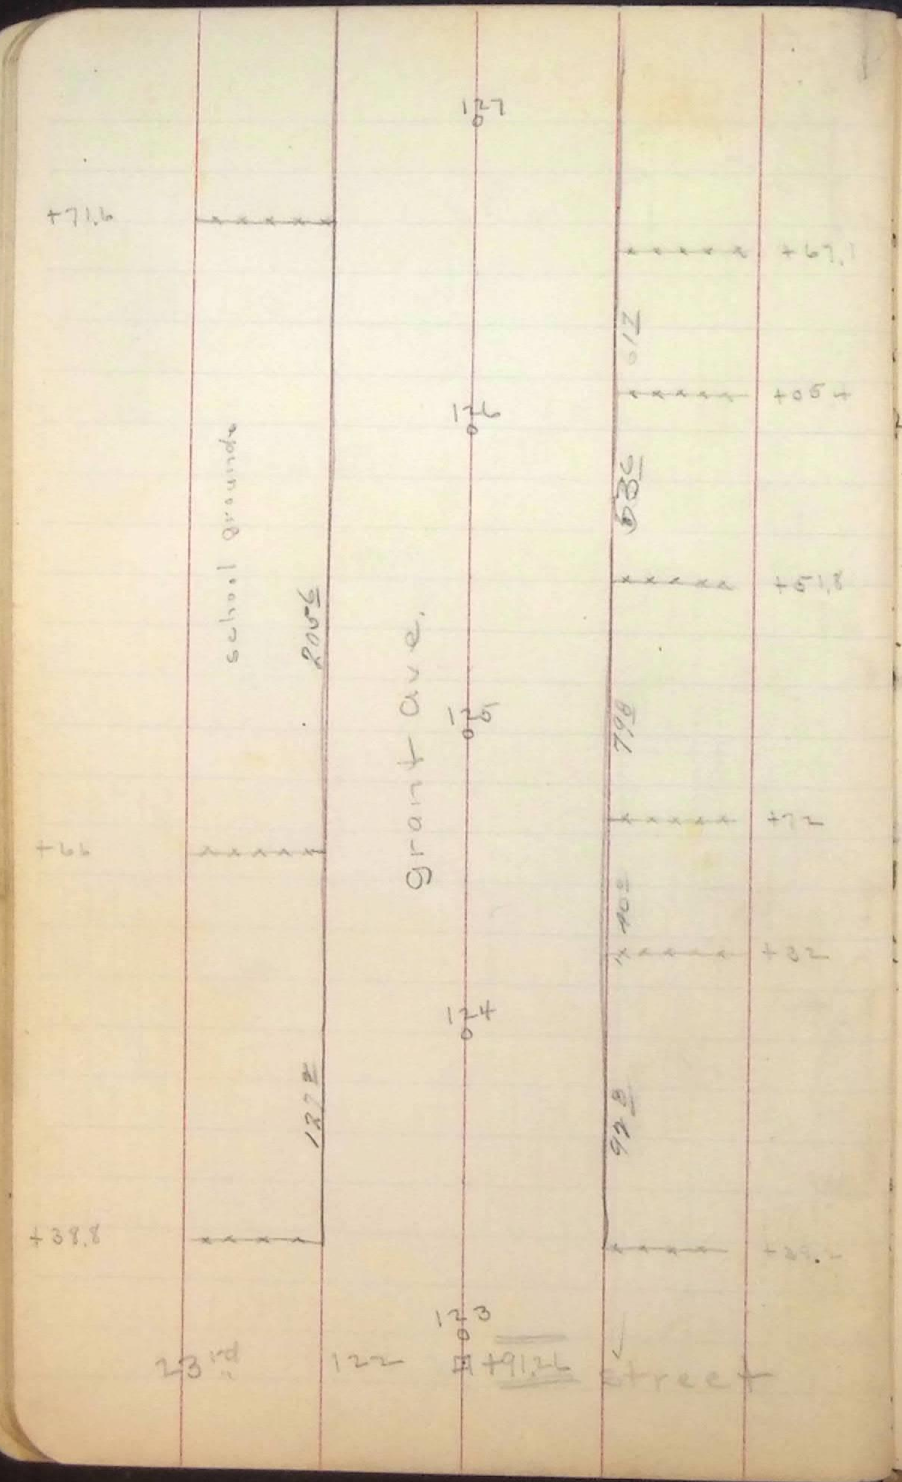
+71.6
+66
+38.8
School Grounds
127.2
Grant Ave.
127
126
125
124
123
23rd
122
+91.26
street
+67.1
+65.4
+51.8
+72
+32
+29.-
Z10
336
