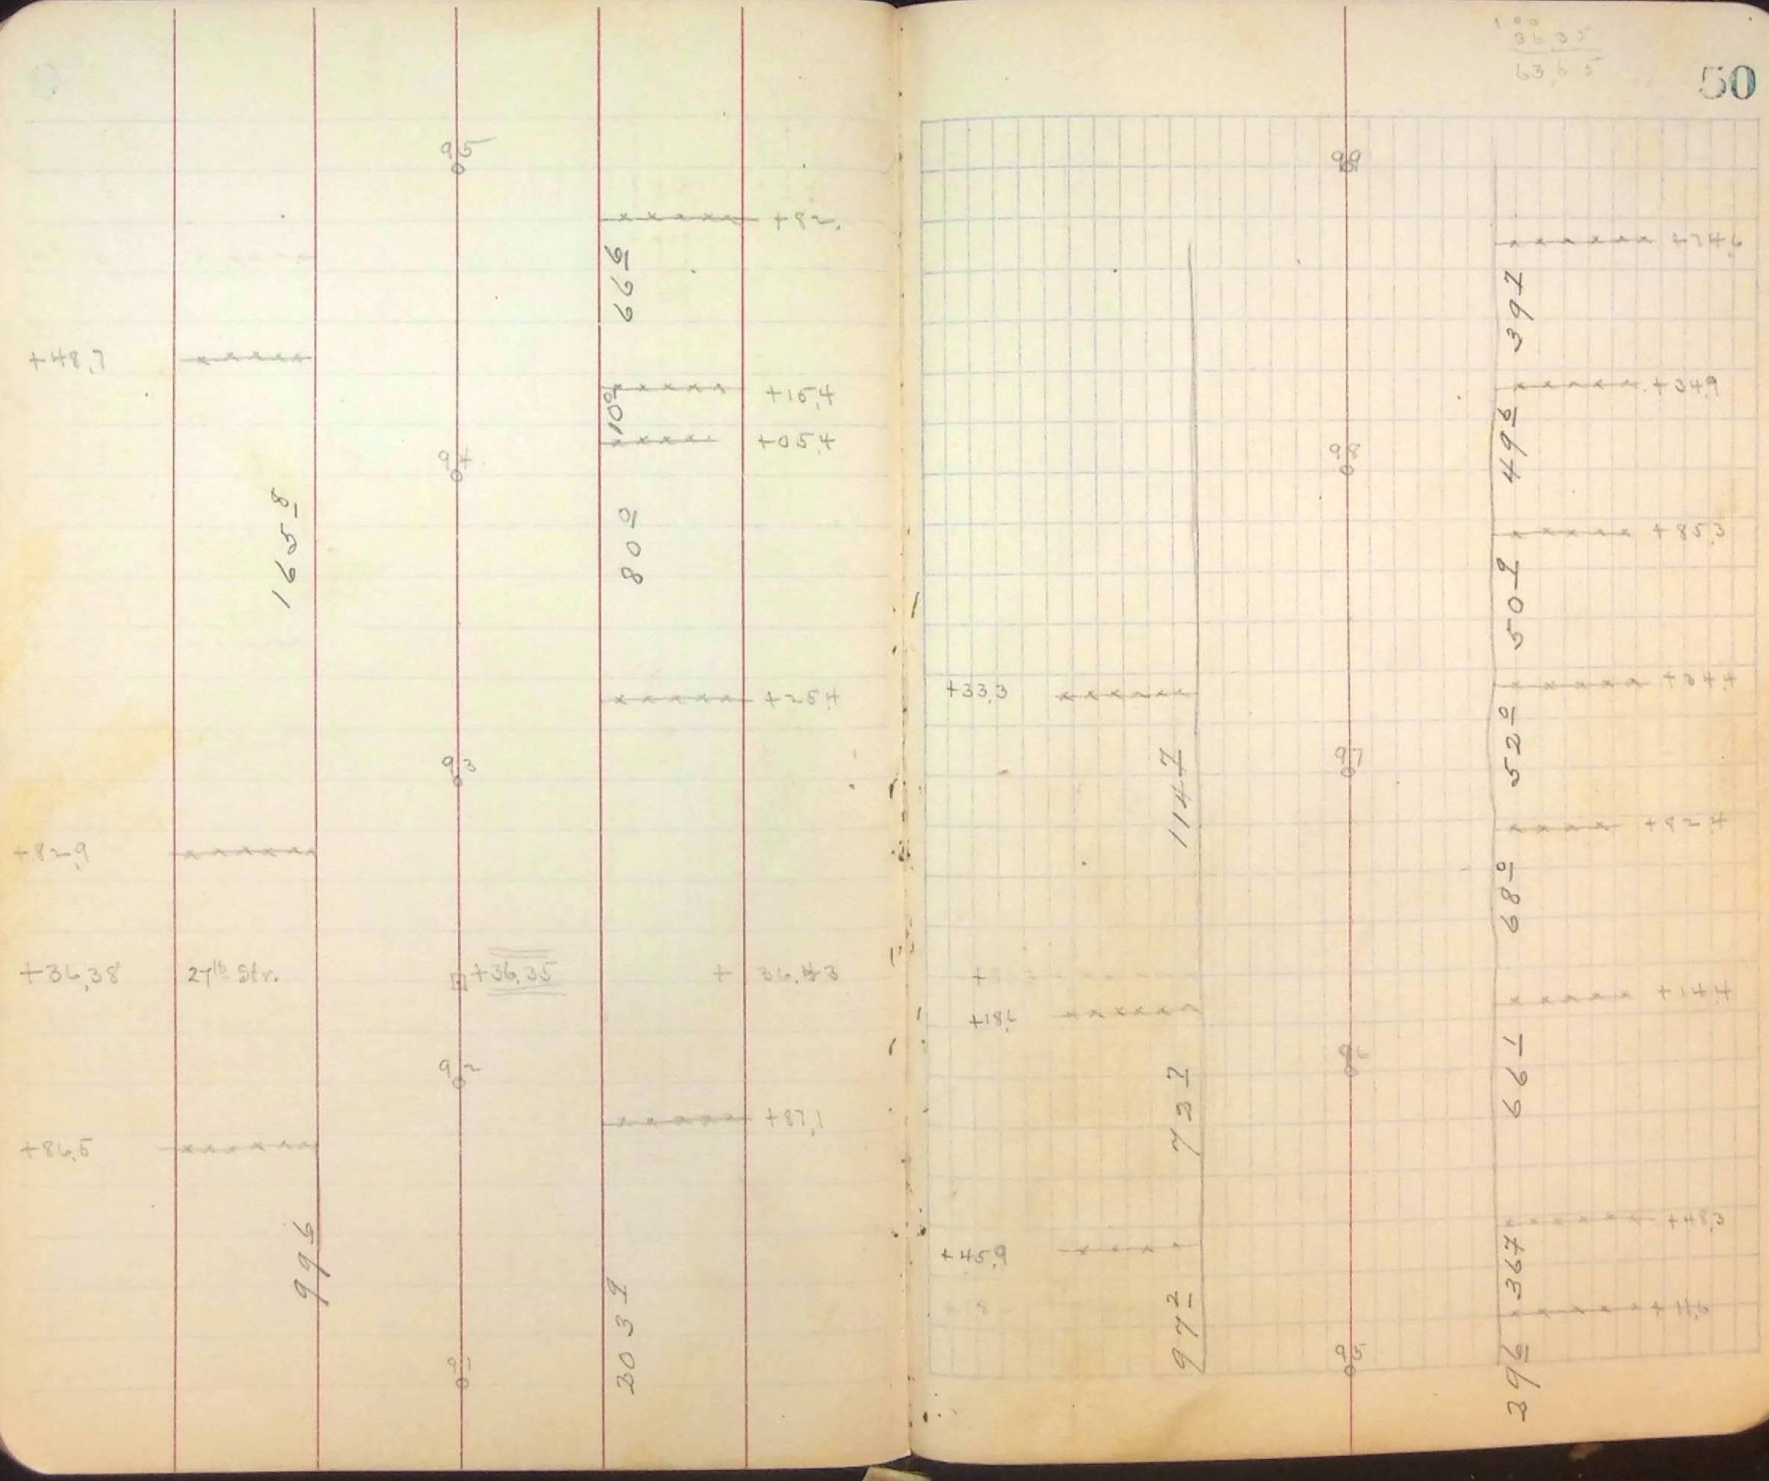

+48,7
+82,9
+36,38
27th Str.
+86,5
+36,35
+36,43
+87,1
+25,4
+05,4
+15,4
+82
+33,3
+18,6
+45,9
+74,6
+34,9
+85,3
+34,4
+82,4
+14,4
+48,3
+11,6