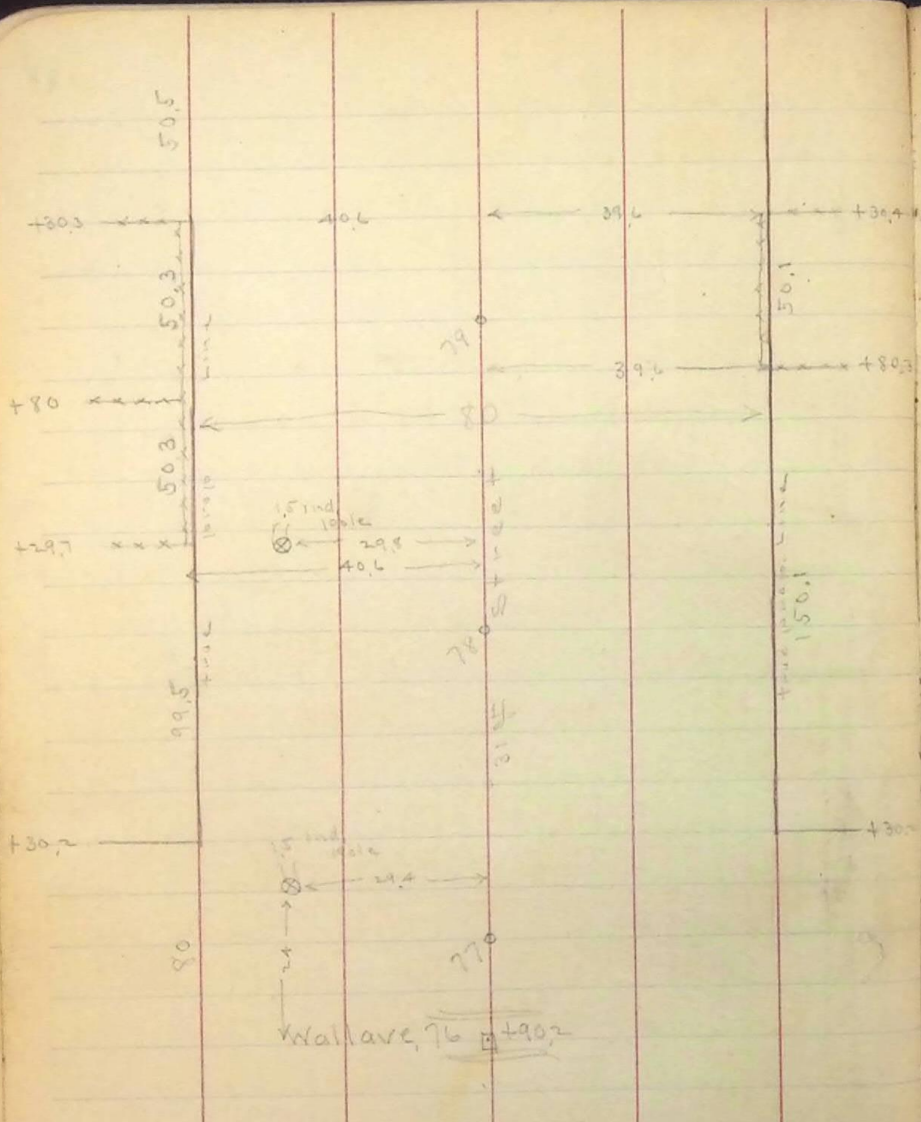

Aug. 26 1905

Meander of 31st St. Wall to Washington — Ave to locate true fence holes etc in Central park addition
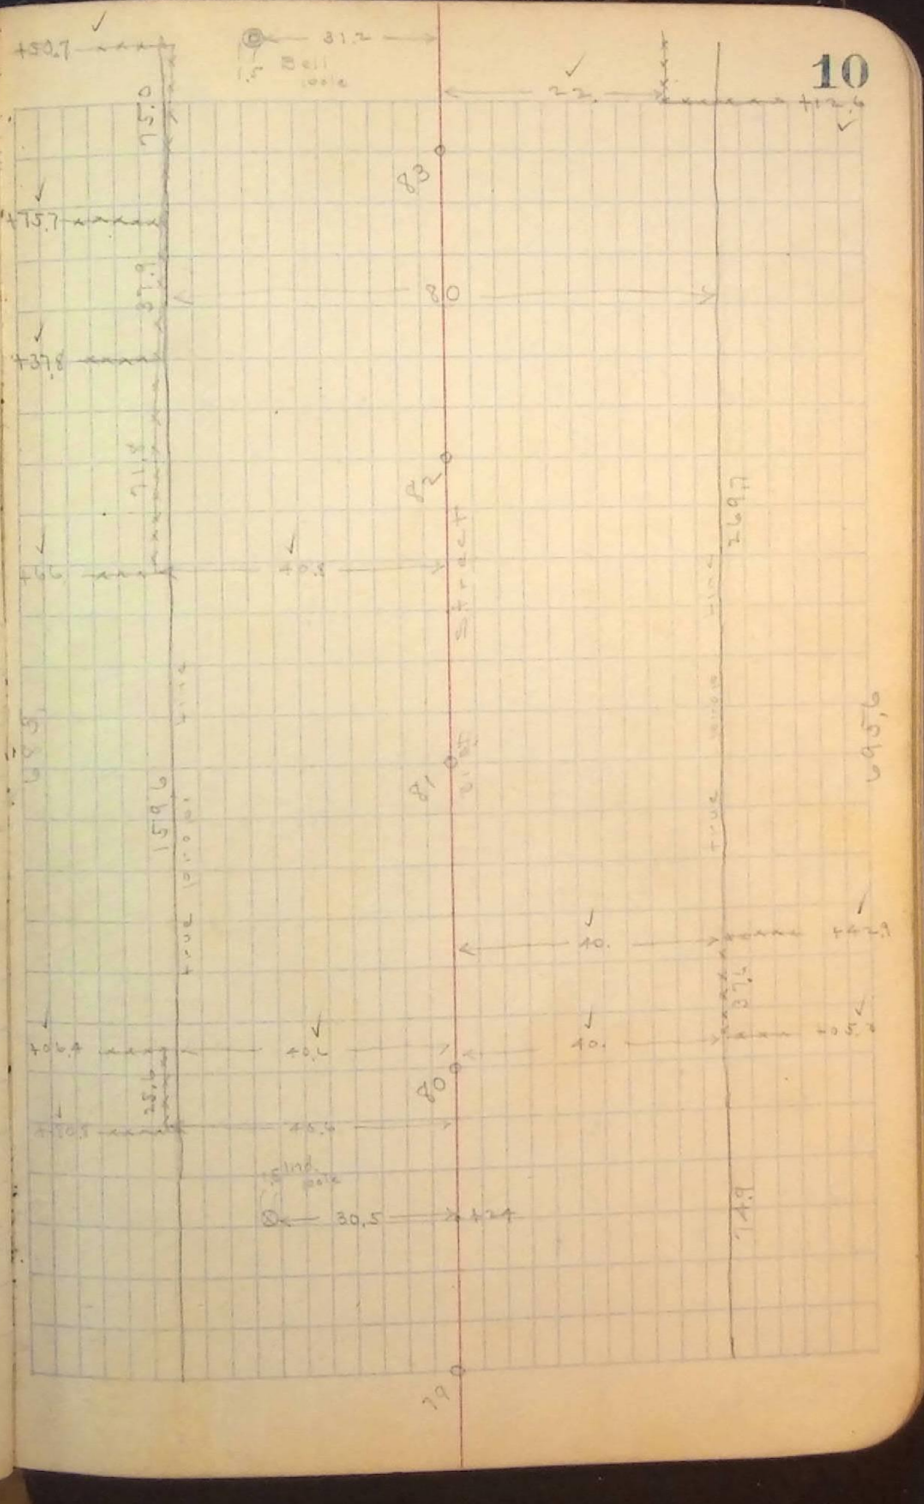
G. K. P. Inst
H. B. S. Chain
J. C. B. "