


ctr. Wall 76 +40.2 Ave.

Left 20 105

Possibly line on 2nd st - all to  
 Hacking  
 9 x 10 ft  
 7 x 10 ft  
 C. B. B. } 10 m - 3 @ m

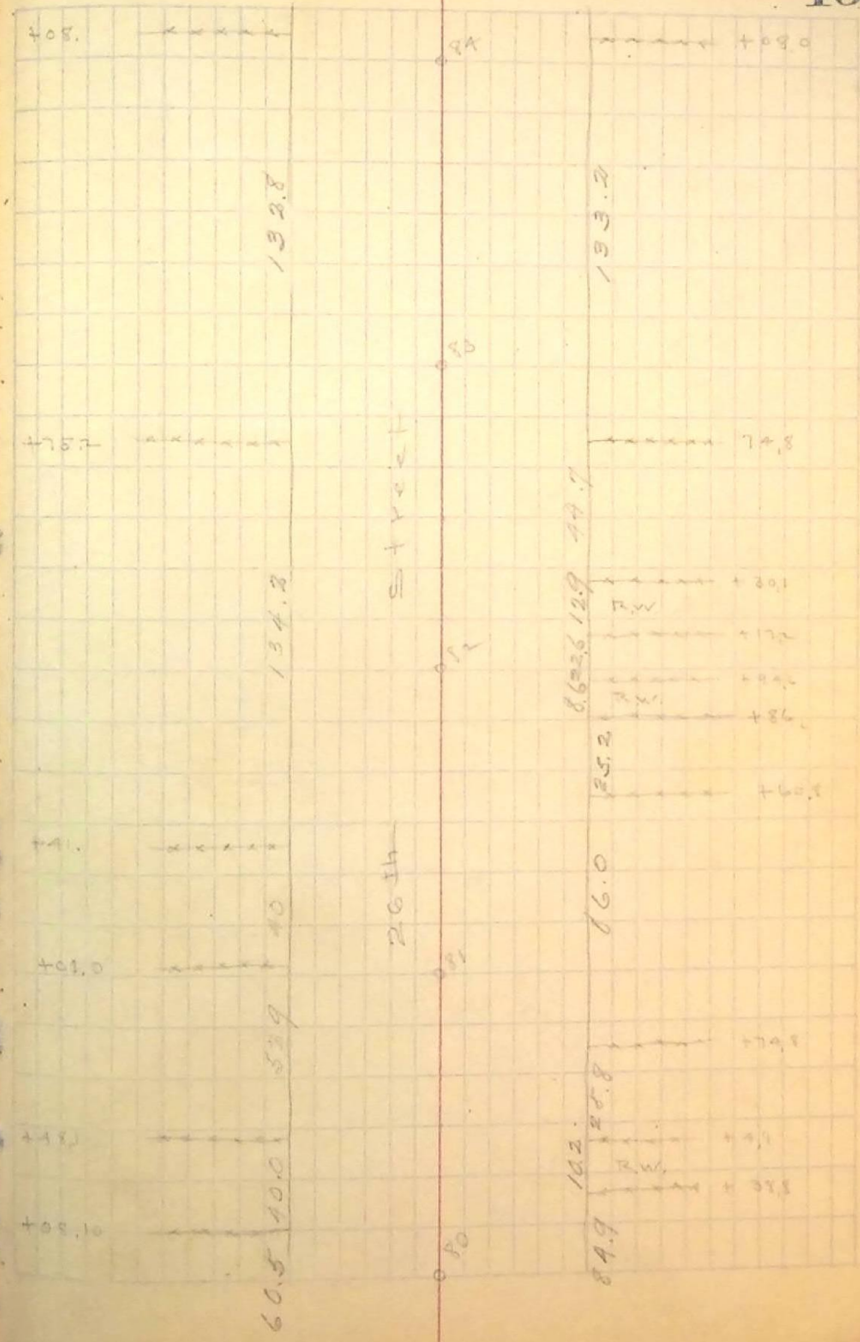

26.7

Street

Left 20 105