


Oct 31 1905 - 9900, 41905

Maximum number of finished cuts & utter  
and Washington Ave. 17th St to 1st St.


Q. 11. P.

Continuing along the same West side = 26717 records. = 26990  
East " = 27010 " = 27000 ~

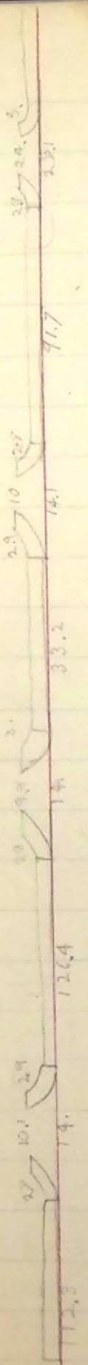


17th Street.

Washington Ave.

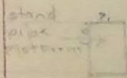

16th Street.  
cañon Road

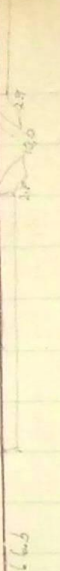

Washington Ave.

