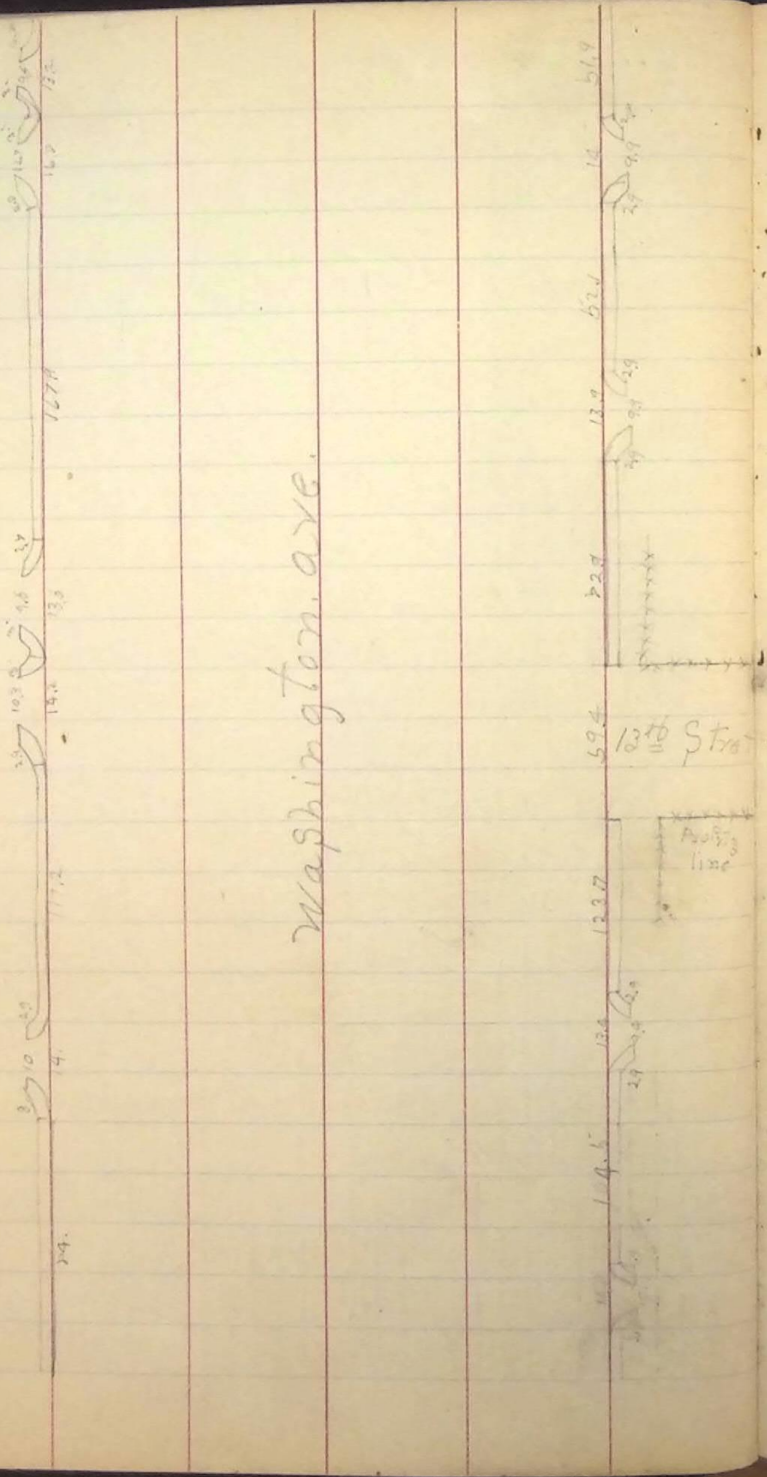
Washington ave.
13th Street
Property line

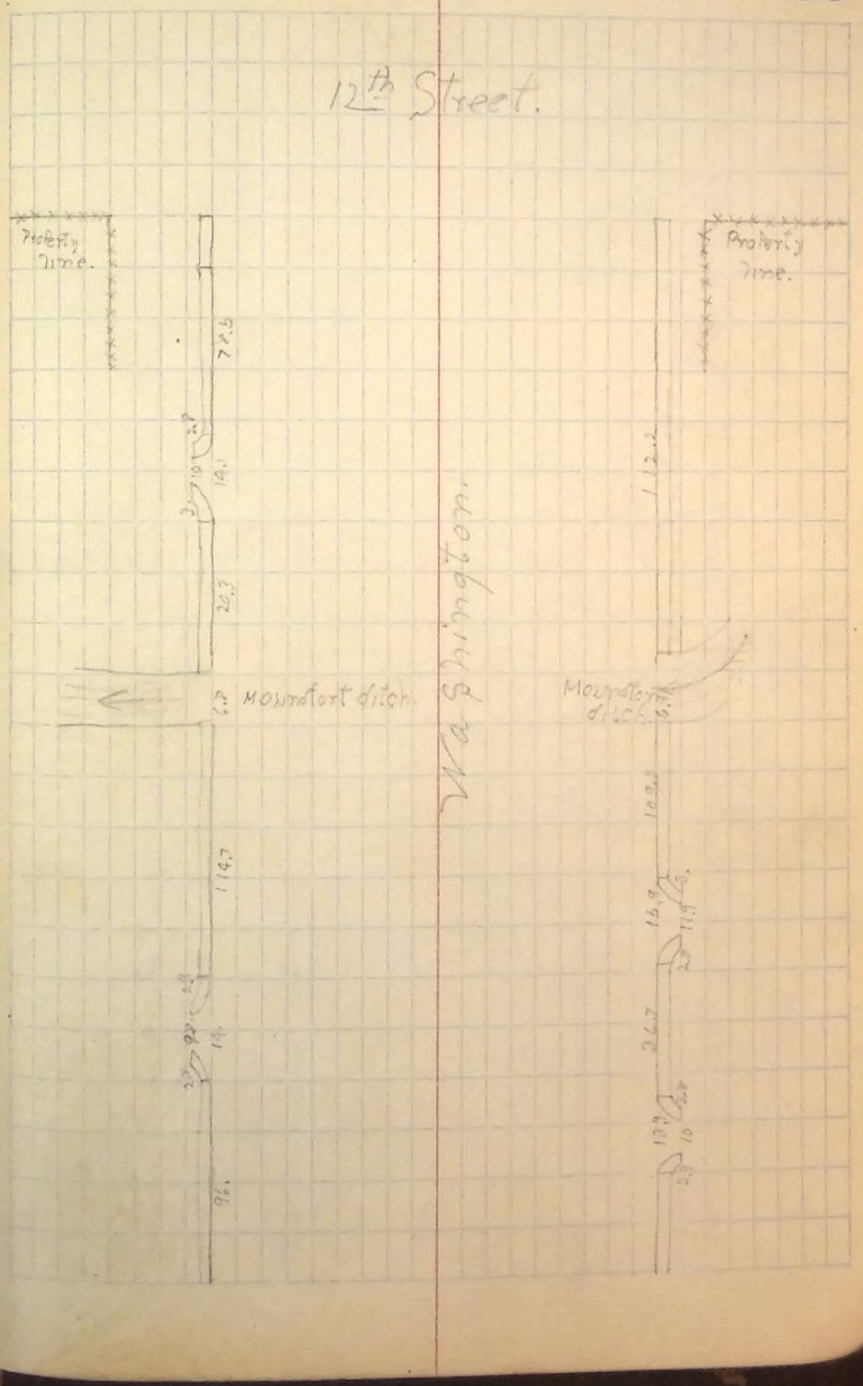
12th Street.
Property line.
Property line.
Mountfort ditch
Mountfort ditch
Washington.