Mar. 2 1905

Survey to check Sht. on 21st st.
Washington to Adams Ave.

9 1/2 A. Sht
11 B.S. Rod
6 S.S. Chain
} 8 0 m. to 4 3 0 P.m.

Sht. over hub at corn Jeff. + 5.94 ft. Sht
South center 21st set previously see
page 40 hub 15 ft. in front set
5.94 ft. South Sht. Wall 0.21 ft. set iron
hub at Adams + Washington
Sht. over Sht. 22nd + Adams. B.S.
on Wt. 21st + Adams. turn 180°
check same set hub sign center of 22nd
+ Jeff. also set iron hub across
offset line at 21st dimen.
Sht. over Sht. 22nd + Washington F.S.
on B.S. South produce to 21st set 18th right to
chaining on nail drive in stringer of bridge
set iron nail across offset line on 21st
make intersection drive nail only check
N.E. quadrant. Sun transit ½ minute in fact
very good. Sht over intersection set
at 21st + Adams, check S.W. quadrant very
good. drive hub. night

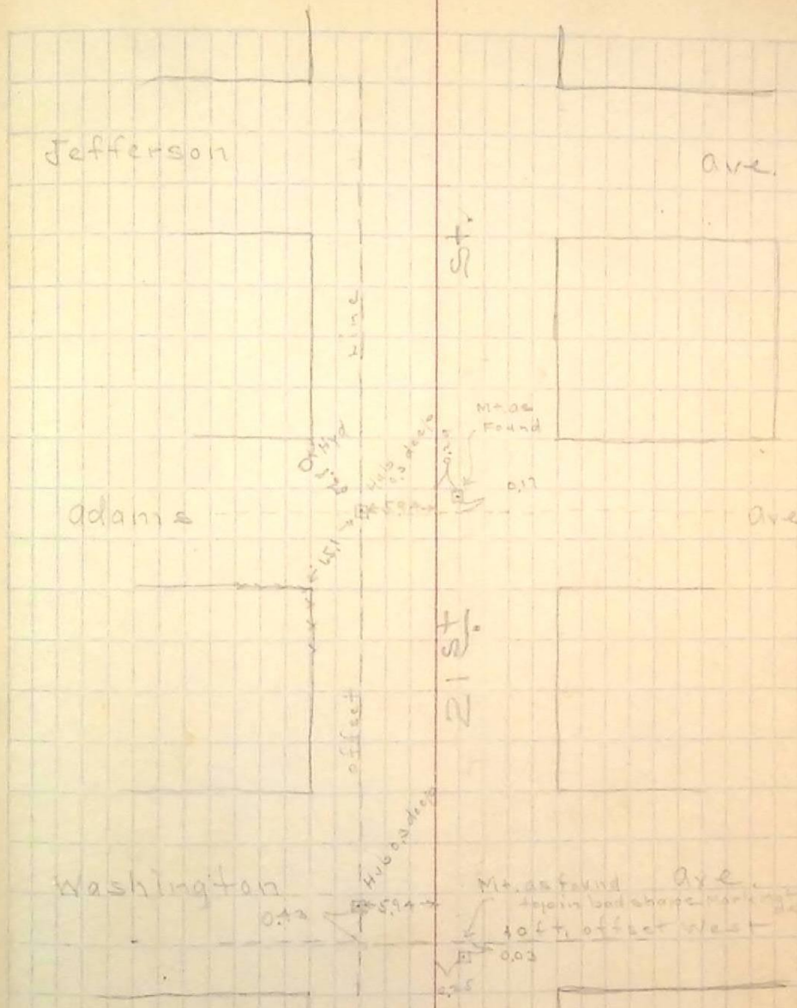
Jefferson
ave.
adams
ave.
Washington
ave.
21st st.
22nd st.
Mag. Nail Found
Mag. Nail Found
5.94
0.17
0.12
0.03
