Oct. 7 1905

Measurements of finished interior for Estimate

G.K.P. says
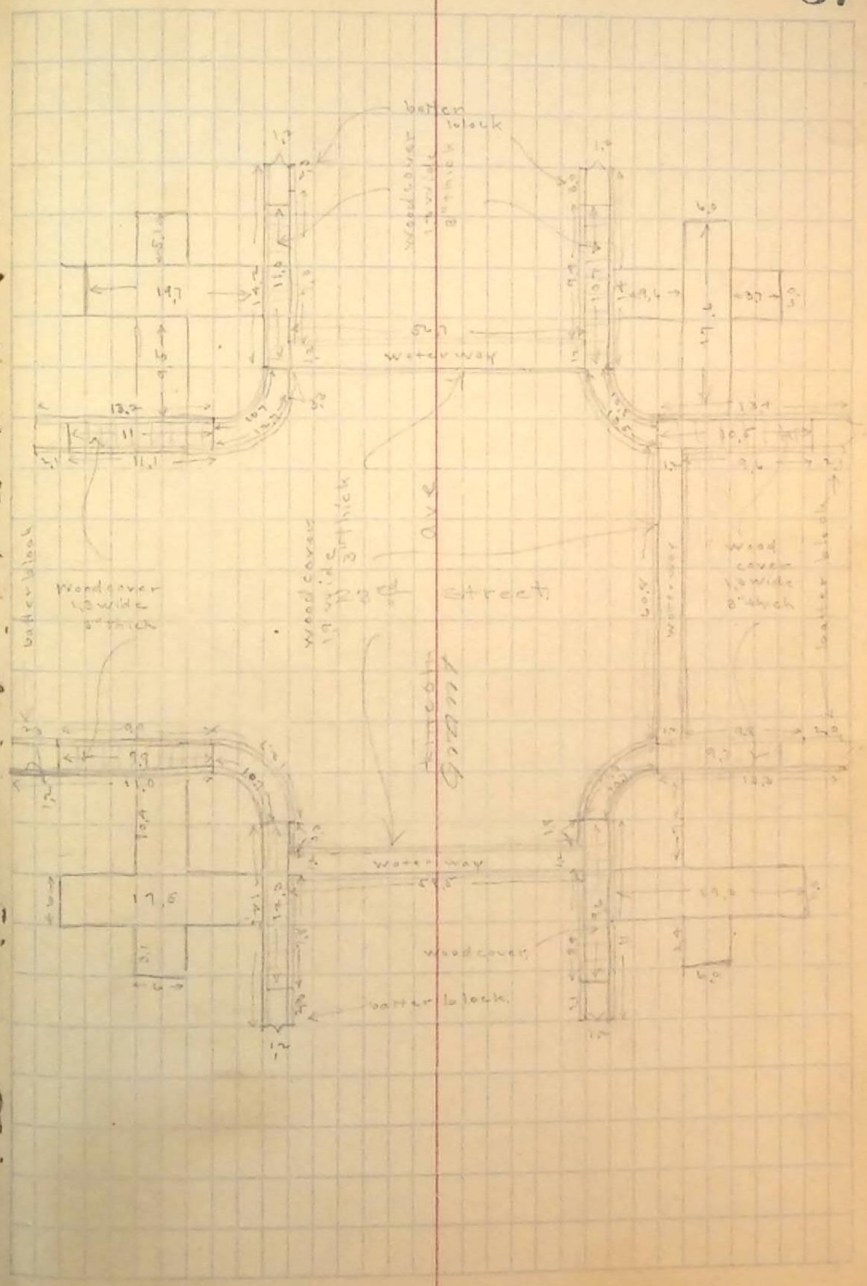
O.K.P.
H.B.t.
L.L.B.
} same to 10 a.m.