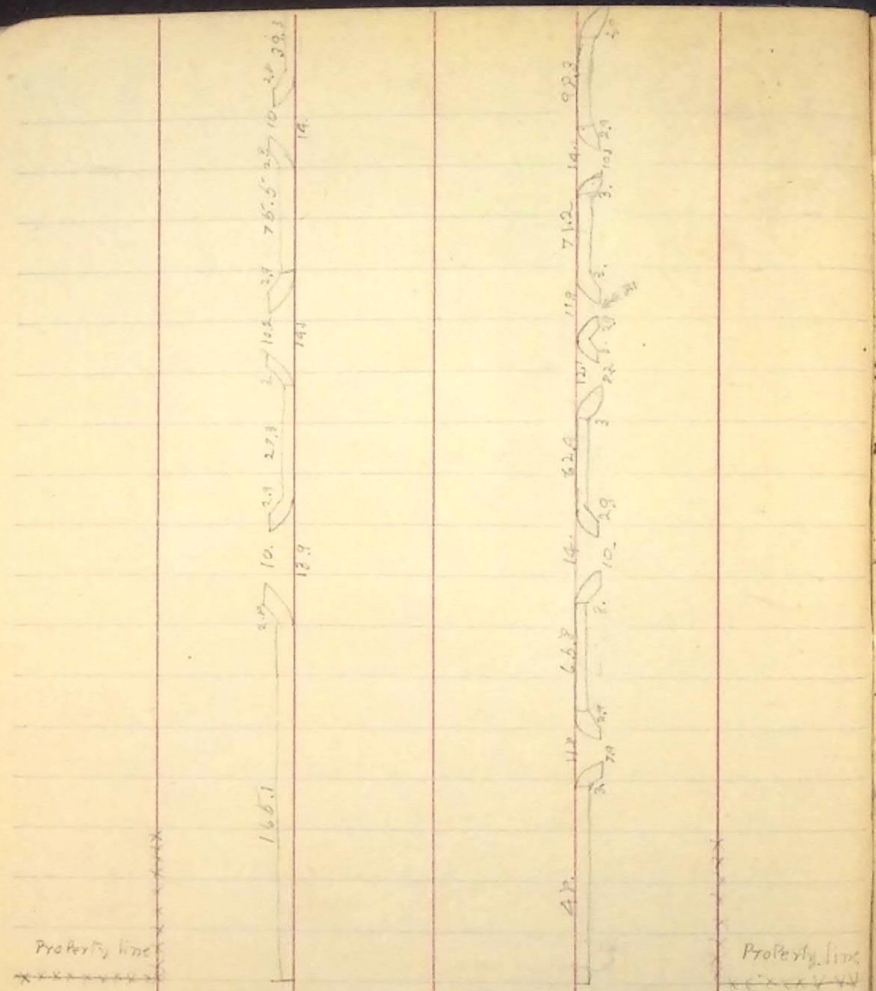

Wall ave.
and 26 Street.

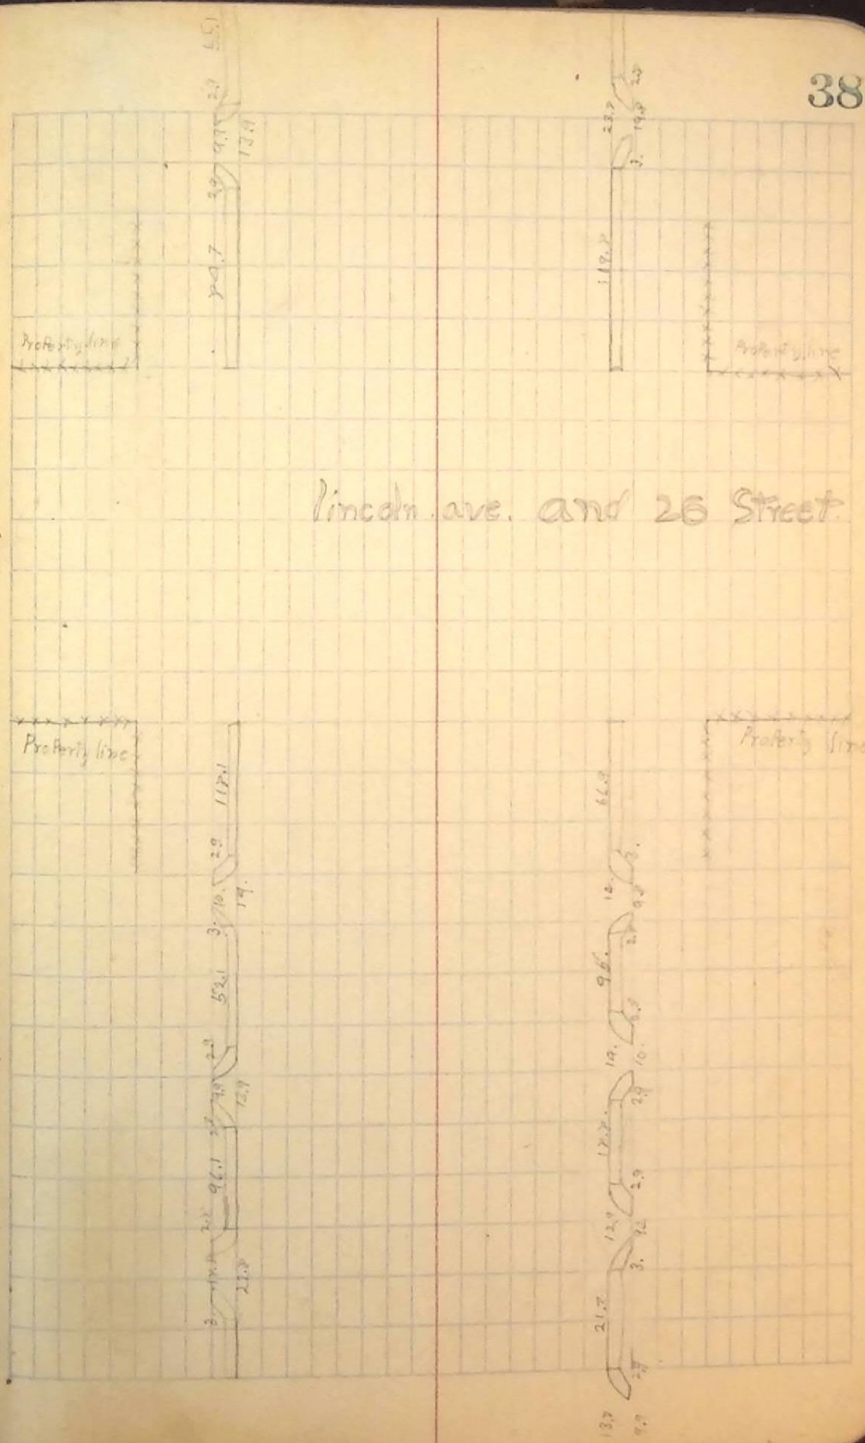

Lincoln ave. and 26 Street.