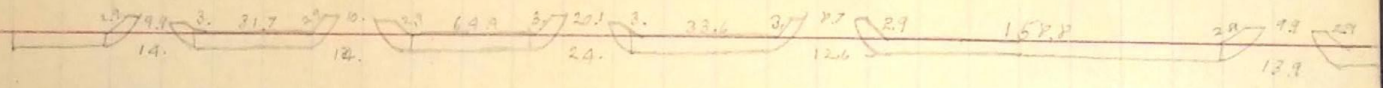

26 Street

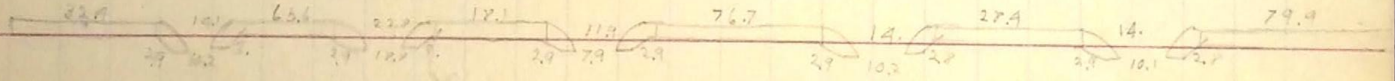

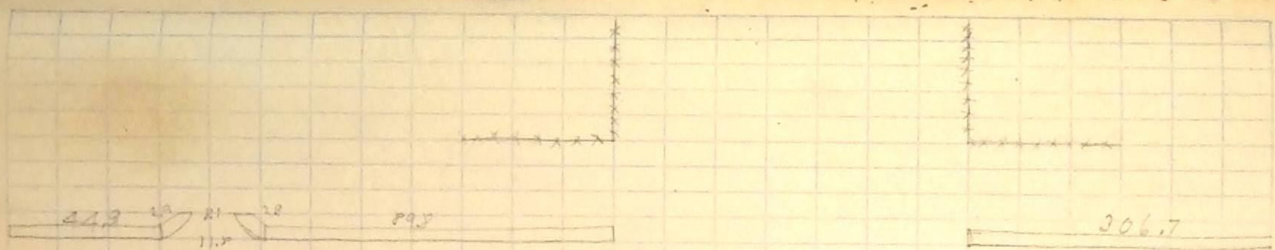
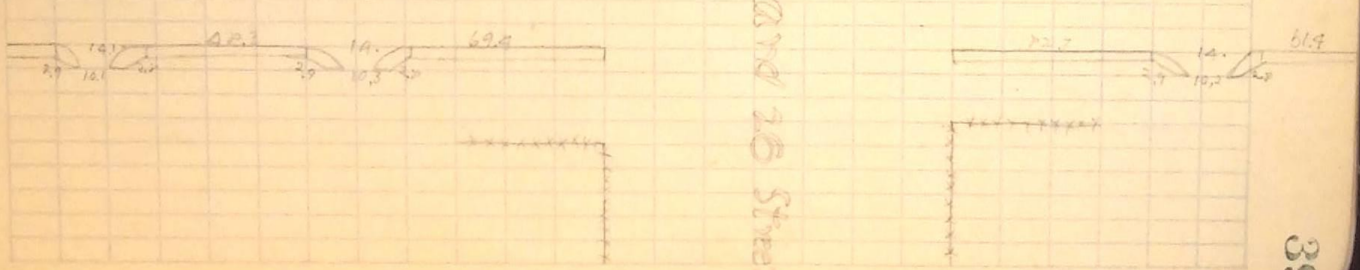
Grand Ave. and 26 Street