

1st Street.


961.6 O.K.

East "

"

"

966

3.7 10.3

67.7


14

27.3

5.7


Bridge

Washington Ave.

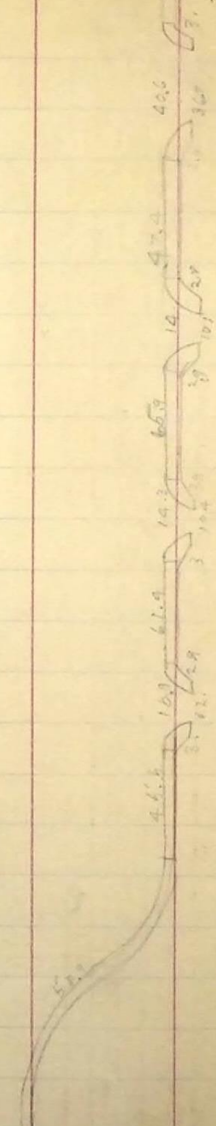



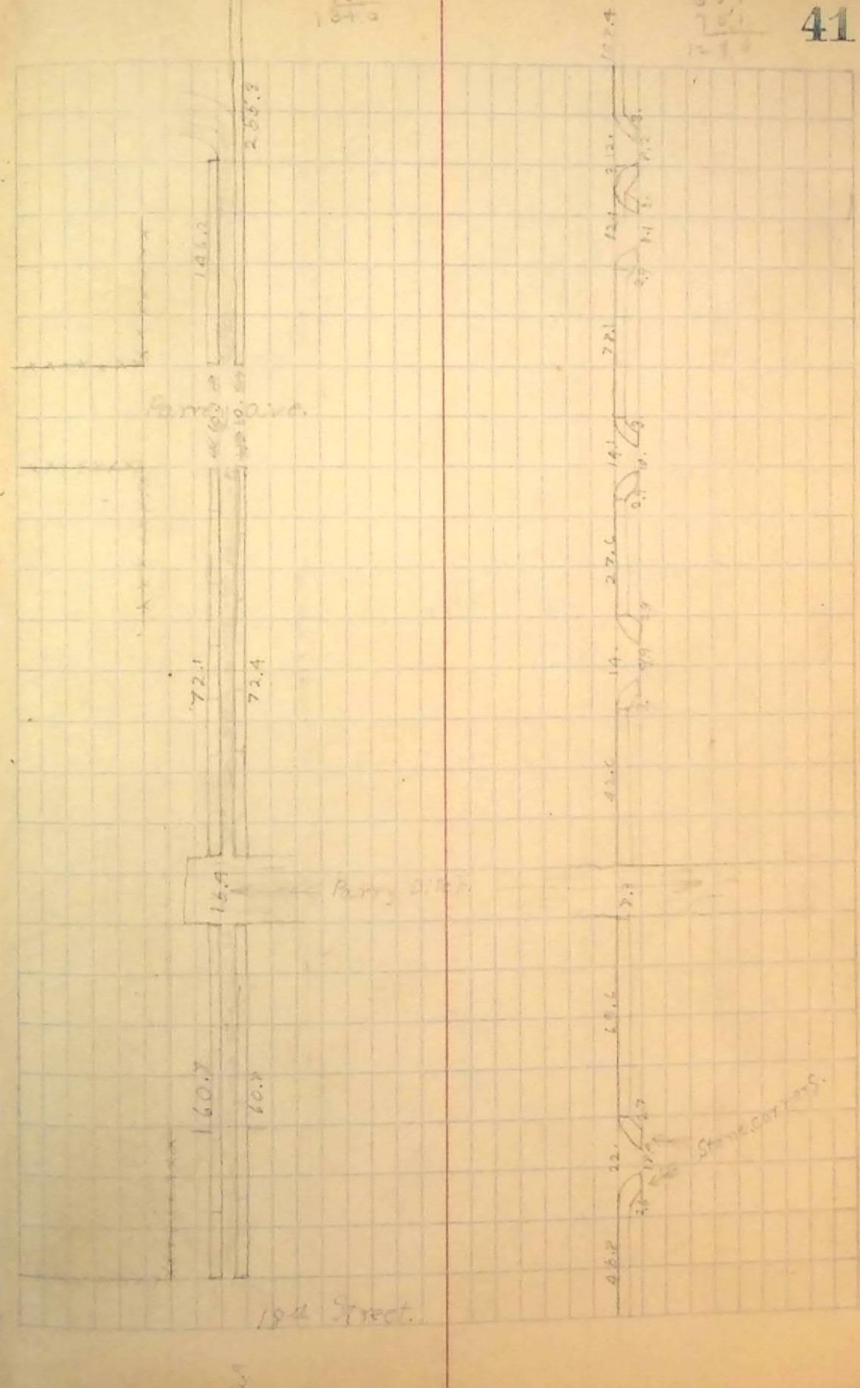

184 Street.

