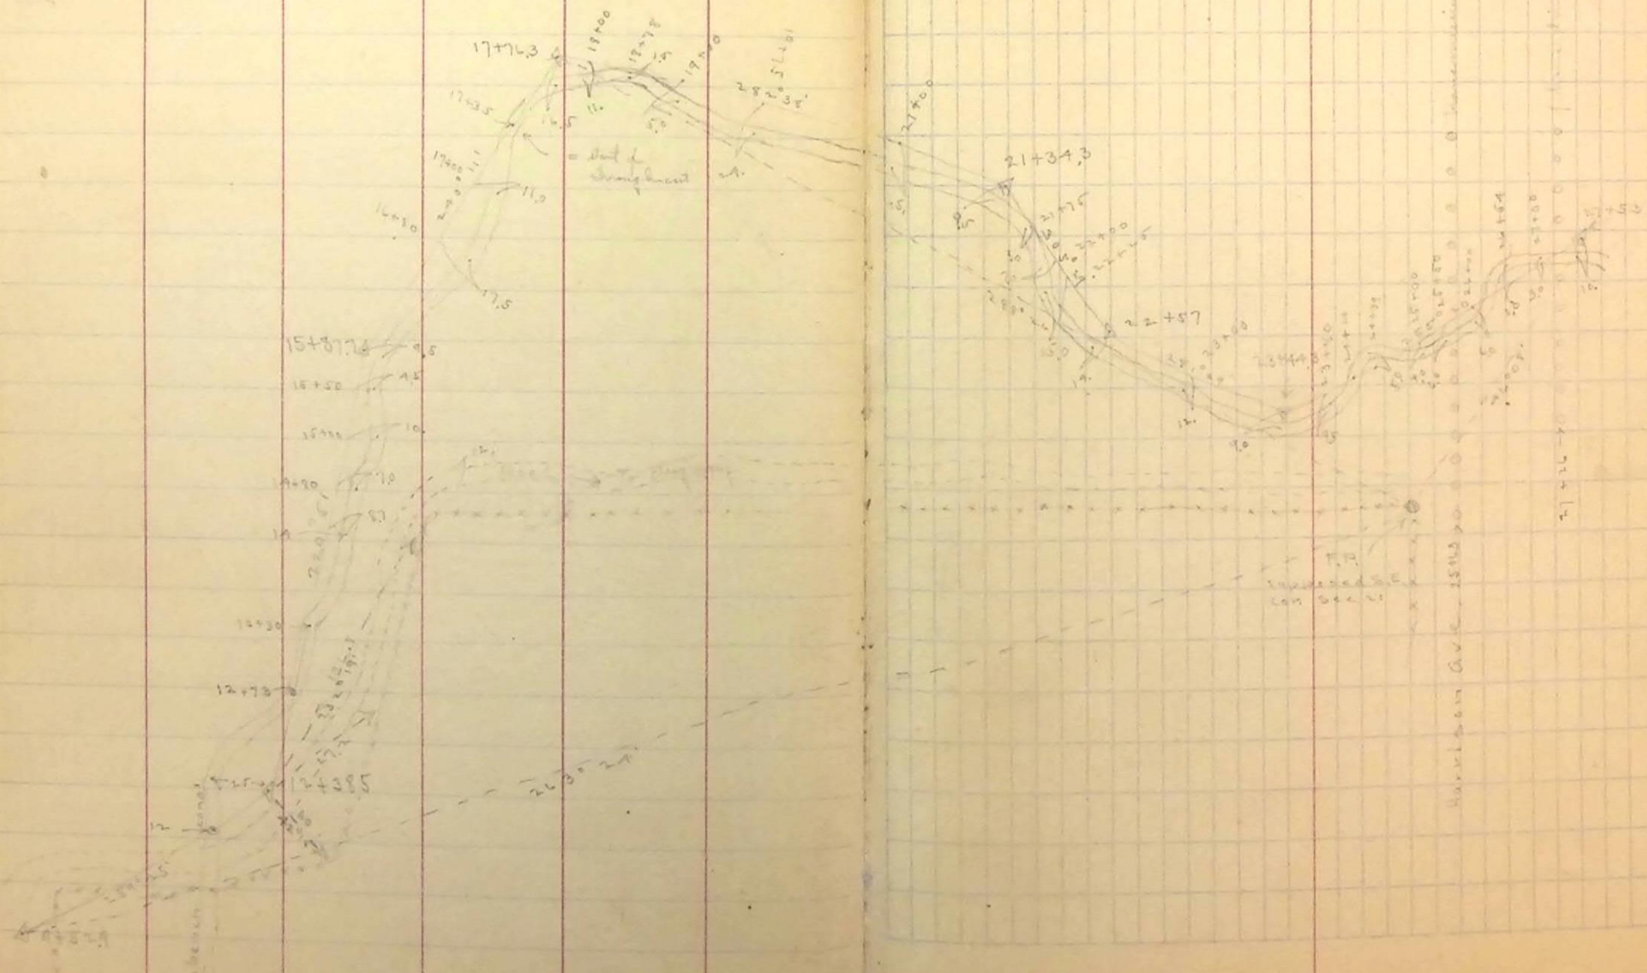Note
ditch is from
6 to 7 ft. wide