April 1905

Measurements of finished intersection of 23rd & Adams, for J. P. O'Neill Contractor
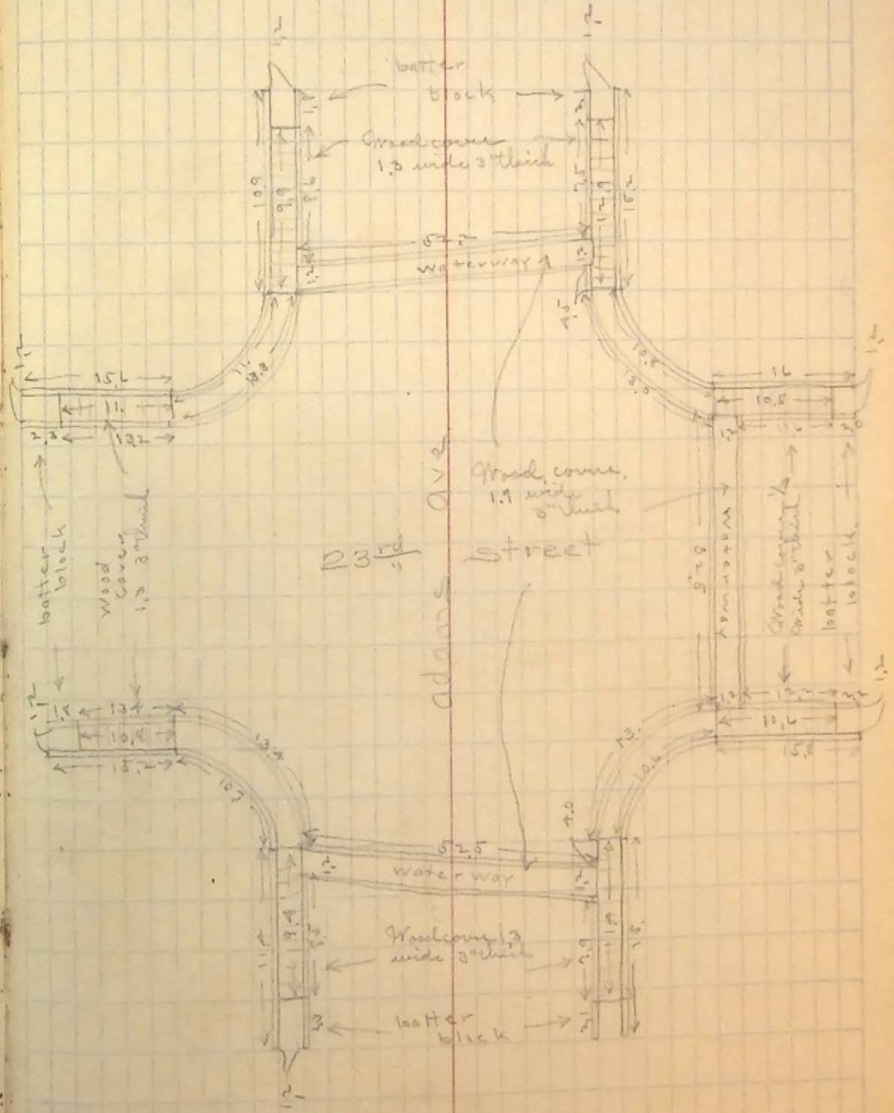
H. & B. } + lbr.
& b. & B. }