


Oct. 1905

concrete

Measurements of water ways for estimate on Washington & 21st also

H.B.L. }
C.B.B. }

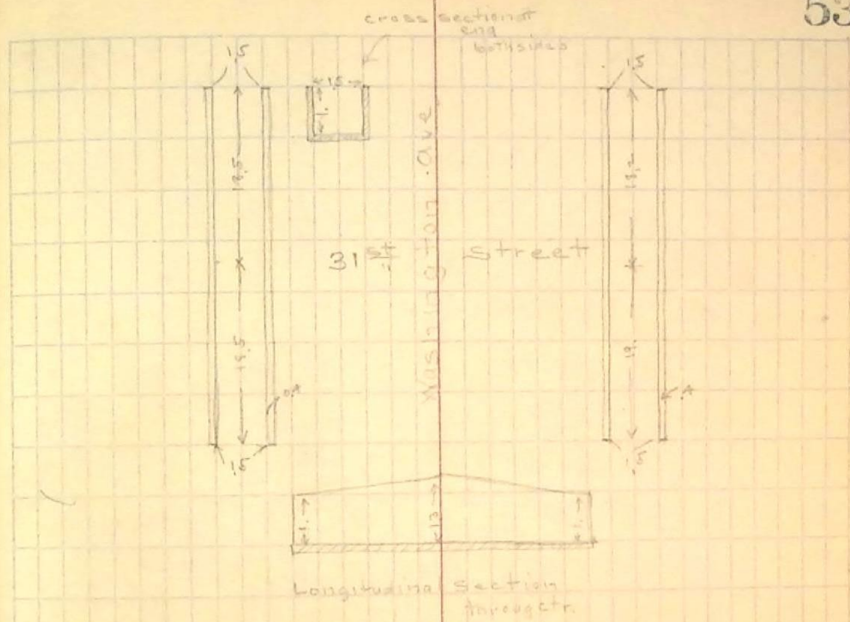

21st + Washington
south side

