








3rd st. on the ground

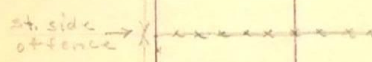

*Tree lot on corner of
from No. 1st St. and
add. corner of 1st and 2nd
then here of 1st and 2nd
west of 1st and 2nd
7/1/19*

Washington Ave.

Bostaph's 36 Hub

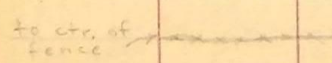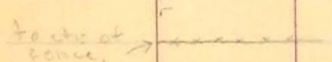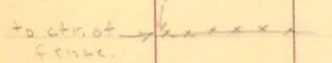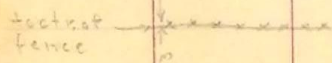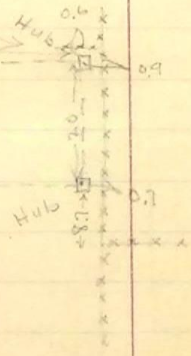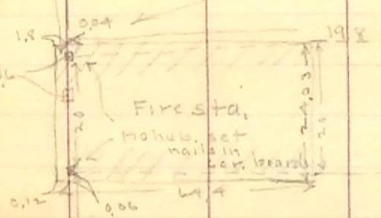

4th st. on the ground

