

May 13 1905

Side walk grade for Max Davidson

#653-59 21' ft. fr. #156

9 1/2 @ Inlet

1 @ D. Q. Rod } 1 @ Curb Rod + @ Curb

4 @ S. Chain

Sta #	H.I. or Grd Elev.	Curb Rod	S.W. Rod	cut or Fill
-------	-------------------	----------	----------	-------------

B.M.	4373.11	on Man	21' at Madison	H.H.
	+ 4.34			
H.I.	4377.45			
119+69.53	70.21	7.24-75	6.49	0.2 left
120+10.53	70.60	6.85-75	6.10	0.3
120+51.53	70.98	6.47-75	5.72	0.1

- 6.09

0 4371.36

+ 2.56

H.I. 4373.92

- 2.67

0 4366.25

+ 1.92

H.I. 4368.17

- 11.10

0 4357.07

+ 1.23


H.I. 4358.30

- 6.57

0 4351.72

+ 2.39

H.I. 4354.11

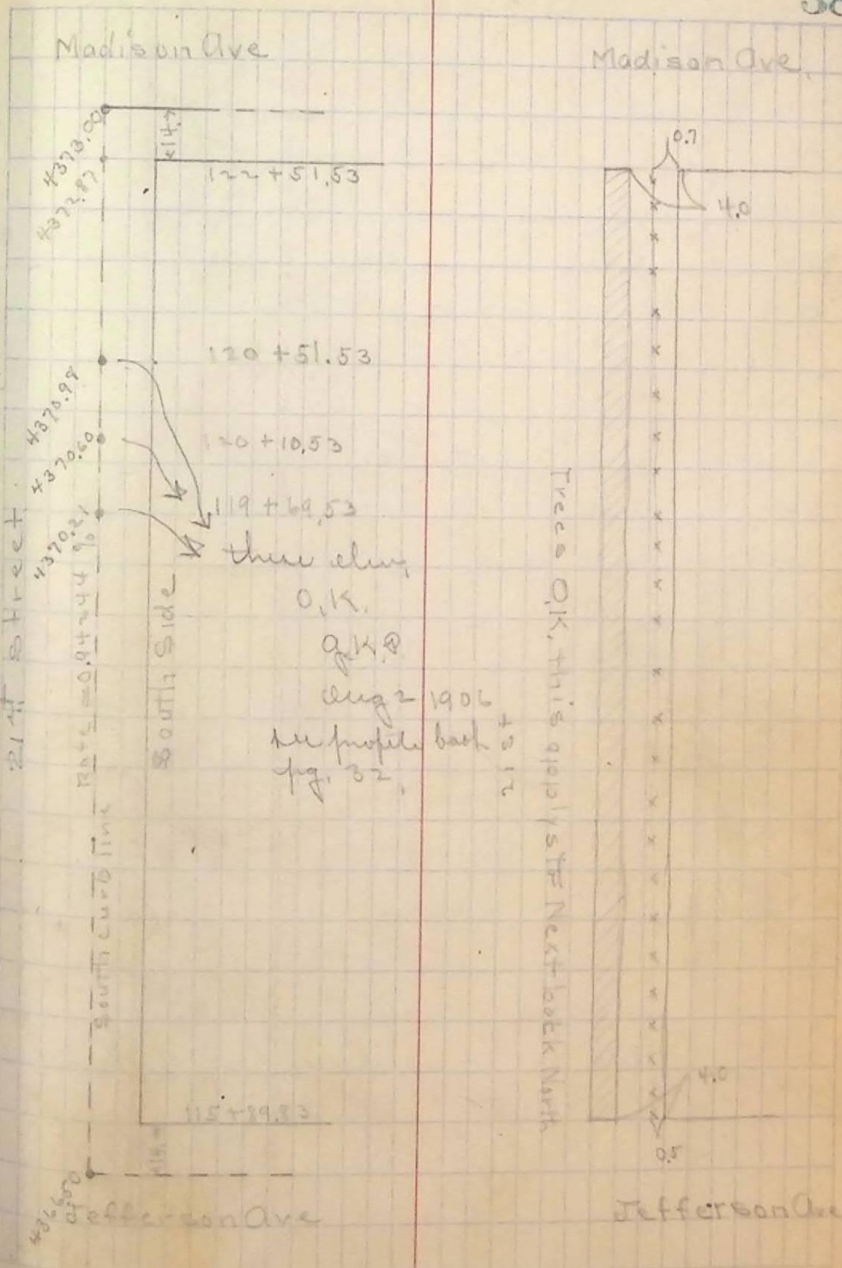

Trees O.K. this applies to Next back Mark

on Mont 21' at Madison 4345.10