

May 15 1905

Property line grade for houses #2351

2349 + 2351.

Quincy Ave.

A. K. B. Inst

A. D. G. Rod

H. B. S. chain

1 P.M. to 3.30 P.M.

Sta	H.I. or Elev	curved prop. Rod	cut. or Fill
-----	--------------	------------------	--------------

B.M.	4406.02	on Mont. 24 th &	Quincy
------	---------	-----------------------------	--------

+ 2.50

4408.52

H.I.

118+399	0310	5.42 - 5	4.92	F04
---------	------	----------	------	-----

118+999	0280	5.72 - 5	5.22	F04
---------	------	----------	------	-----

119+599	0250	6.02 - 5	5.52	F04
---------	------	----------	------	-----

- 5.52

4403.00

+ 3.79

4406.79

- 6.31


4400.49	ch. B.M. Mont. 23 rd &	Quincy
---------	-----------------------------------	--------

4400.49 H.H.H.

Note

Void Wrong place
should have been lot 9
Blk. 3. instead of lot. 9 Blk 9
Plat "B"

39

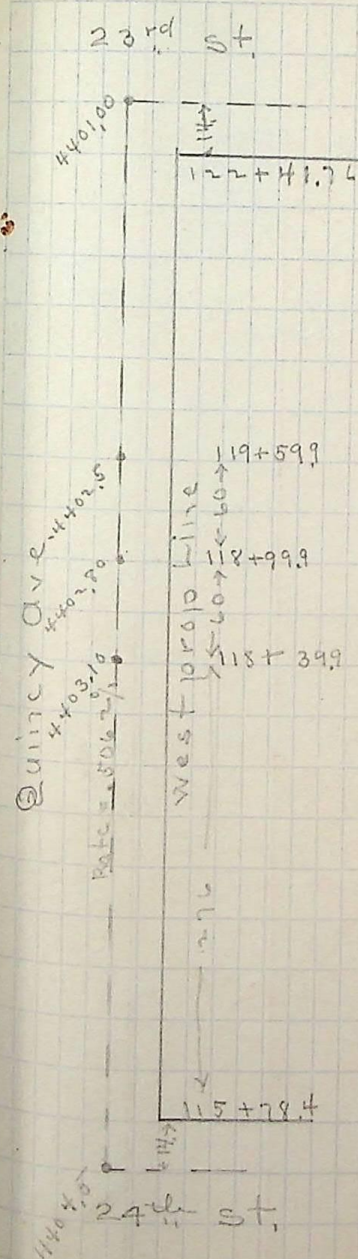

Void see Note Void