

Property line guide Lot 9 B Ch 3

Plat "B" of A. Schubach

Q 73.0 Unit

Q 29.0 Rod

4 B Chain


May 18 1905

1 @ m. to 330 @ m.

Sta. #	H.I. T.P. & Gr. Elev	Curb Rod	Prop. Rod	cut or Fill	
B.M.	H4403.38 + 3.43	W. bolt	To Hyd. 26 th & Monroe page 57 book 7.		
H.I.	H4406.81				
95+52.5	01.60	5.21-5	H31 ✓	F. 2.7	on post
96+18.5	01.50	5.31-5	H81	F. 1.9	stake
96+84.5	01.41	5.40-5	H90 ✓	F. 0.7	on post

Profile

H.I.	H4406.81				
97+50.5	6.3	H4400.50			
99	6.1	00.70			
98+90	6.6	00.70	bot curb across S.W.		
91+50	6.0	00.80			
98+16	5.7	01.10	bot curb across st.		
98	5.7	01.10			
97+50	5.6	01.20			
97	5.6	01.20			
96+80	6.3	00.80	bot curb across S.W.		
96+50	5.6	01.20			
96+29	6.2	00.60			
96	6.9	00.00			
95+50	7.3	H3 99.50			
95	6.1	H4 00.70			
	- 5.78				
	H4401.03				
	+ 5.70				
H.I.	H4406.73				
94+54	5.7	01.00	bot curb across S.W.		
94+50	5.0	01.70			
94	4.7	02.00			
93+88	5.5	01.20	bot " " " " st.		
93+50	5.0	01.70			
93+09	6.1	H3 99.50			
92+86	6.6	99.10			
	- 3.89				
	H4402.84				

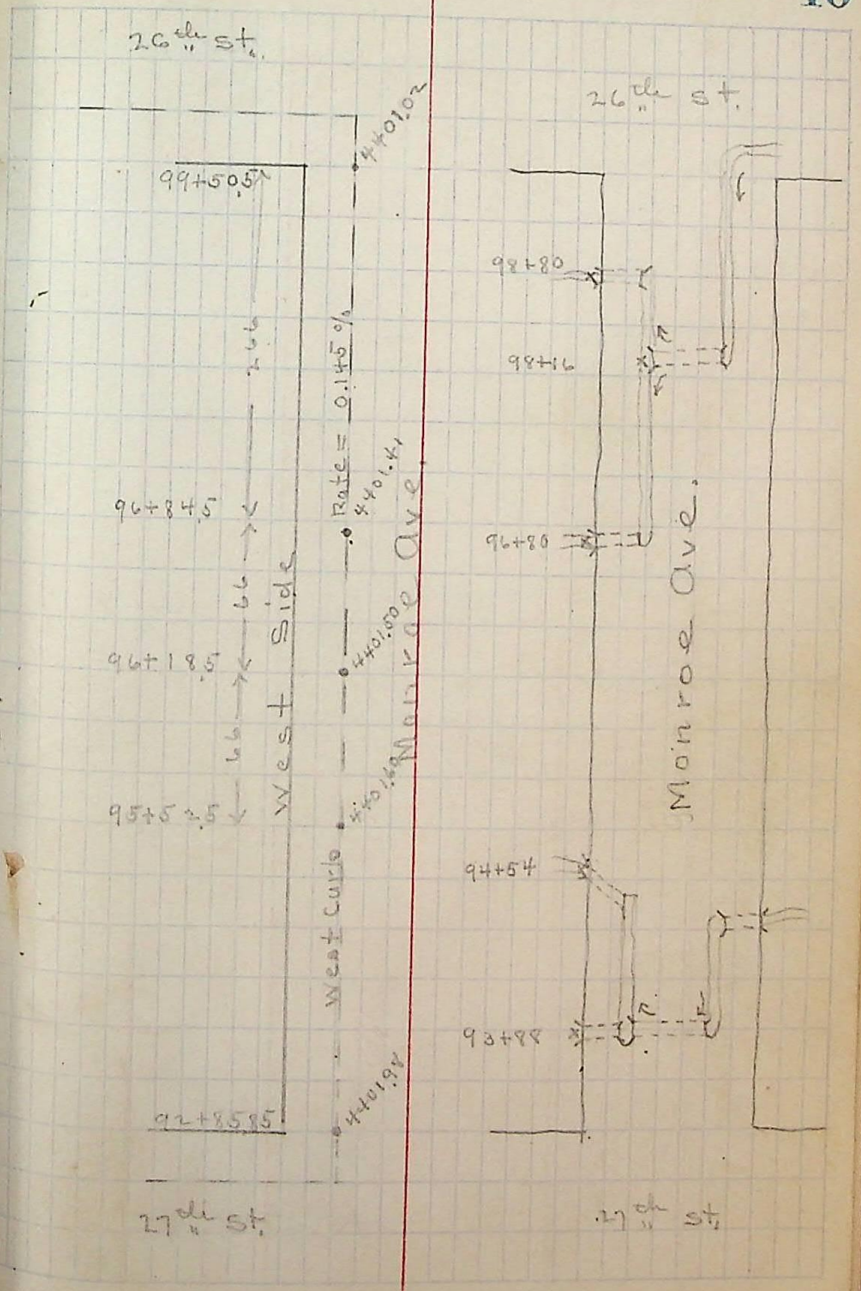

CH B.M. W. bolt to Hyd. 26th & Monroe