

May 23 1905

Side walk grade for White Knight Bros.

#870-74-77-86 20th St. for #162

G.K.P. Int.

A.D.G. Rod

H.B.S. chain

8 am. to 11:20 am.
1 hr. in office
1 P.M. to 2 P.M. underground

Sta #	H.I. T.P. or G.K.P. Elev.	Curbs Rod.	S.W. Rod	cut or Fill
B.M.	+411.25 + 0.13	W. lot T ₁₀	Hyd. 25 th	Quincy G.K.P.
H.I.	+411.39			
137+93.7	08.23	3.15-25	2.90+25	F.12
137+43.7	07.25	4.13-25	3.89 "	F.10
136+93.7	06.27	5.11-25	4.86 "	F.08
136+43.7	05.29	6.09-25	5.84 "	F.07
136+23.7	04.89	6.49-25	6.24 "	F.05

Inside edge of walk set 8 ft. from true property same as block West stakes driven 1 ft. out side walk and 9" or .75 below grade I marked stake set at sta 137+93.7 F. 9" from top all stakes


H.I. +411.39
- 6.30
+405.09
+ 0.74
+405.82
- 6.20
+399.62

drove curb grade for 24 ft. S.W. 3 ft. incl. curb.

CH.B.M. E. 6.11 T₁₀ Hyd. 25th + Quincy
+399.62 G.K.P.

Quincy Ave.

Quincy Ave

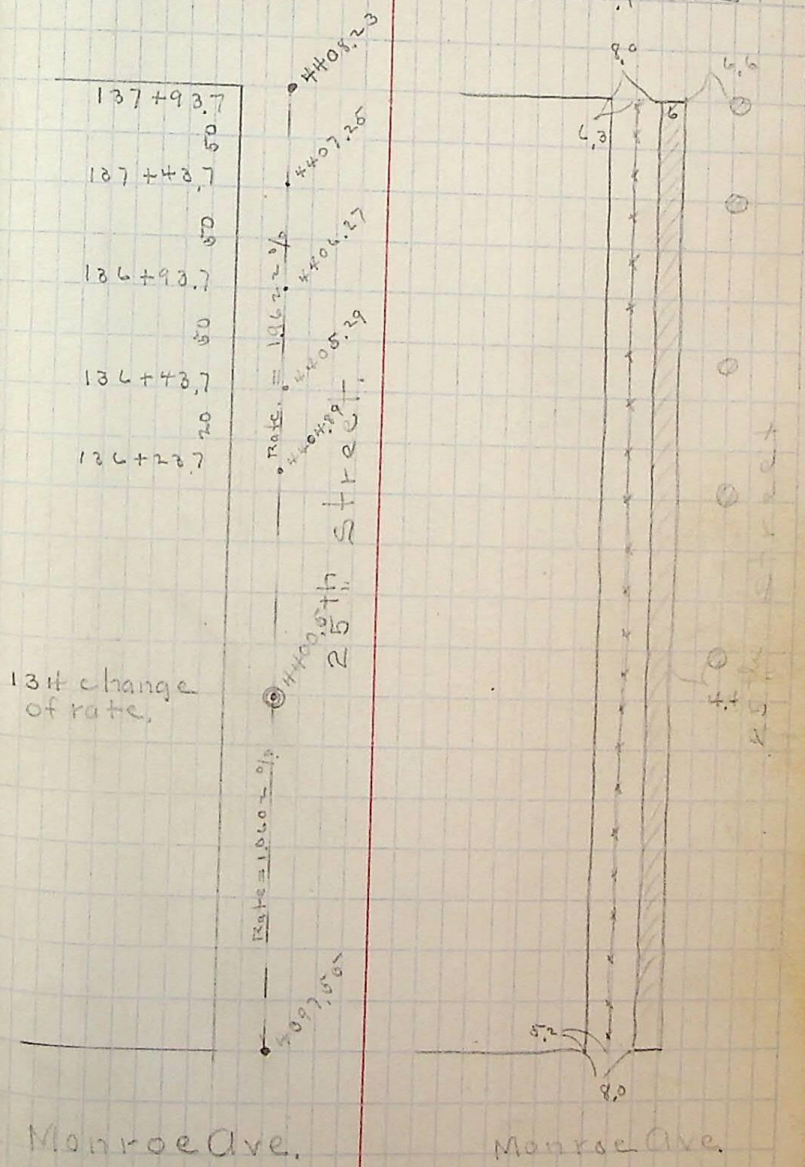

Monroe Ave.

Monroe Ave.