

July 7th 00


Property line guide for Smith &
Humphreys on N.W. cor. 23rd &
Jeff.

9.14 P. Inst }
14 B. & Rod } 10:30 am. to 11:00 am.
66 B. & Chain }

B.M. 437289 on Box Elder N.E. cor. 23rd & Jeff.
4.35

H.I.	437724			
71.93	5.31 - .5 =	4.81 ✓	stake on cor. 5th	
71.60	5.64 - .5 =	5.14 ✓	on post blue	
71.27	5.97 - .5 =	5.47 ✓	" "	"
70.94	6.30 - .5 =	5.80 ✓	" "	"
70.61	6.63 - .5 =	6.13	" "	" " N.E.

22nd

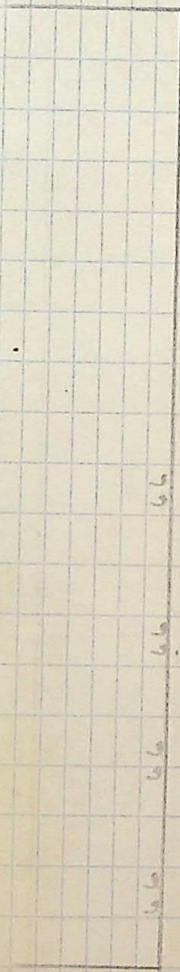

23rd