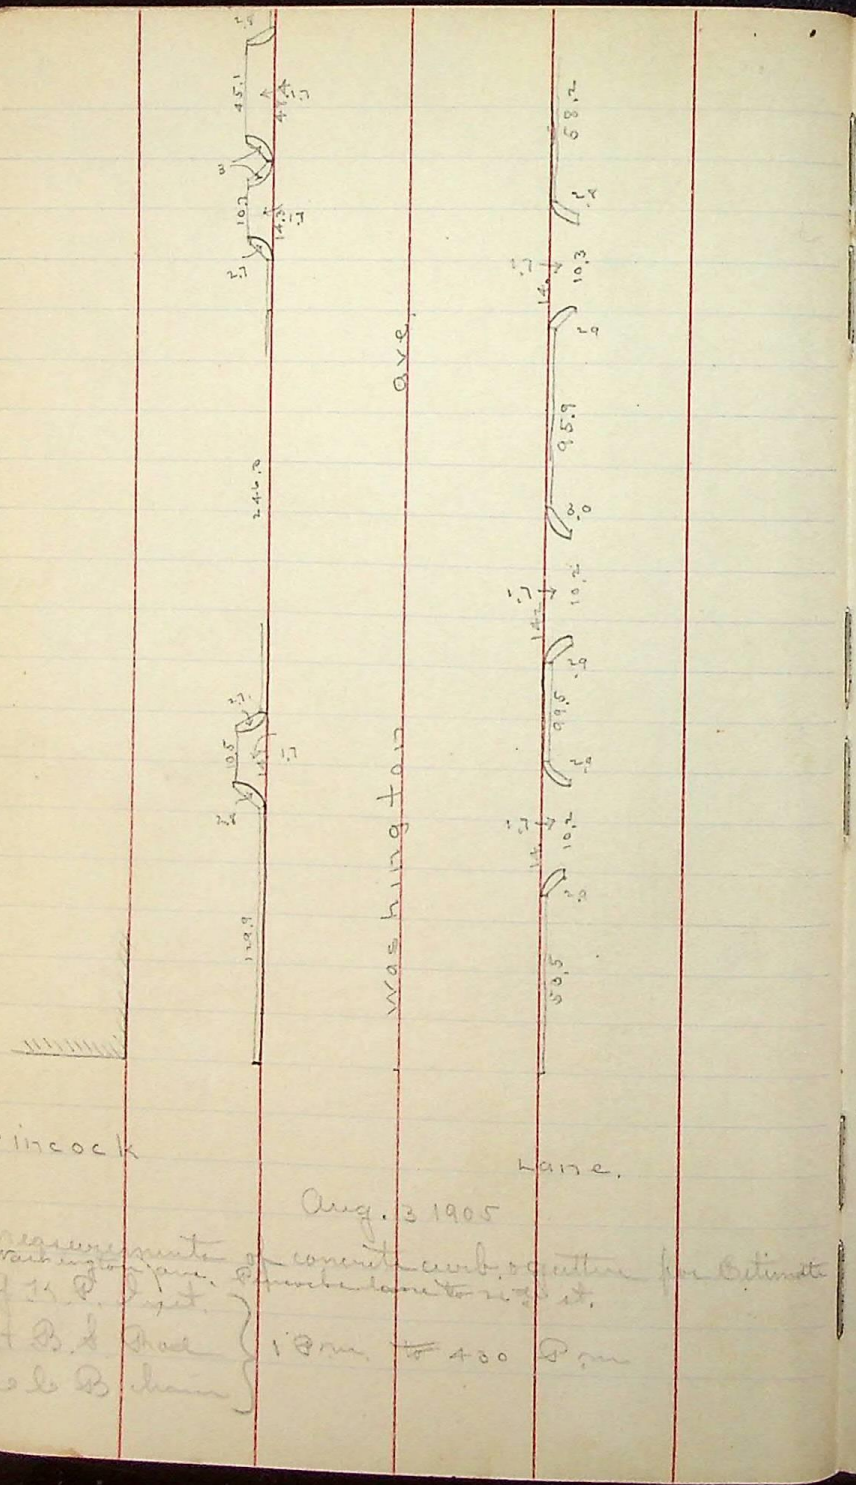

Pincock

Aug. 3 1905

Measurements of concrete curb & gutter for Estimate
9 11 P. Unit.
H B. I Road
lo lo B. Lane

