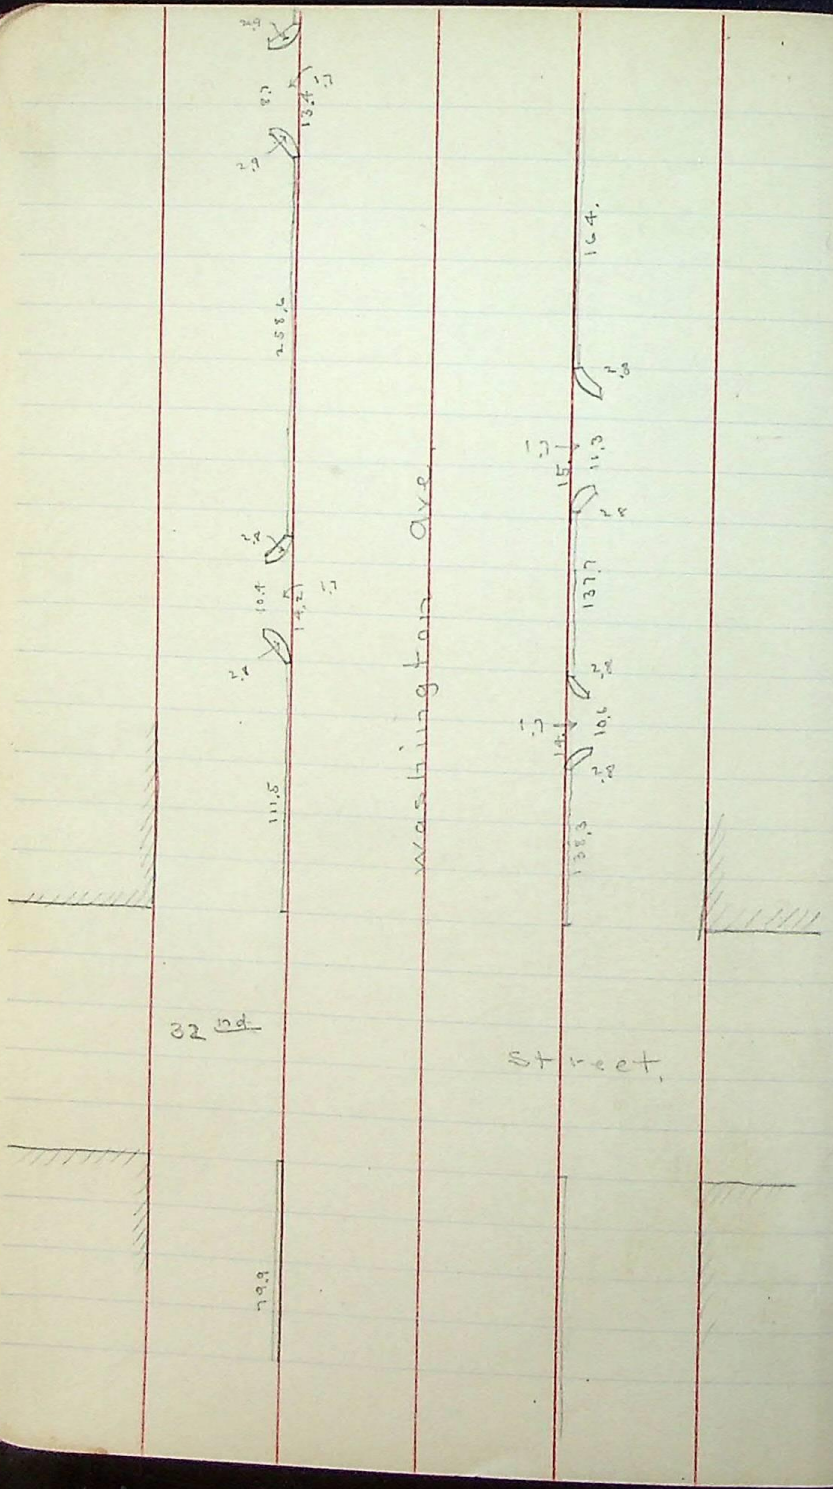
Washington Ave
32nd
Street
258.6
111.5
79.9
164.
137.7
138.3

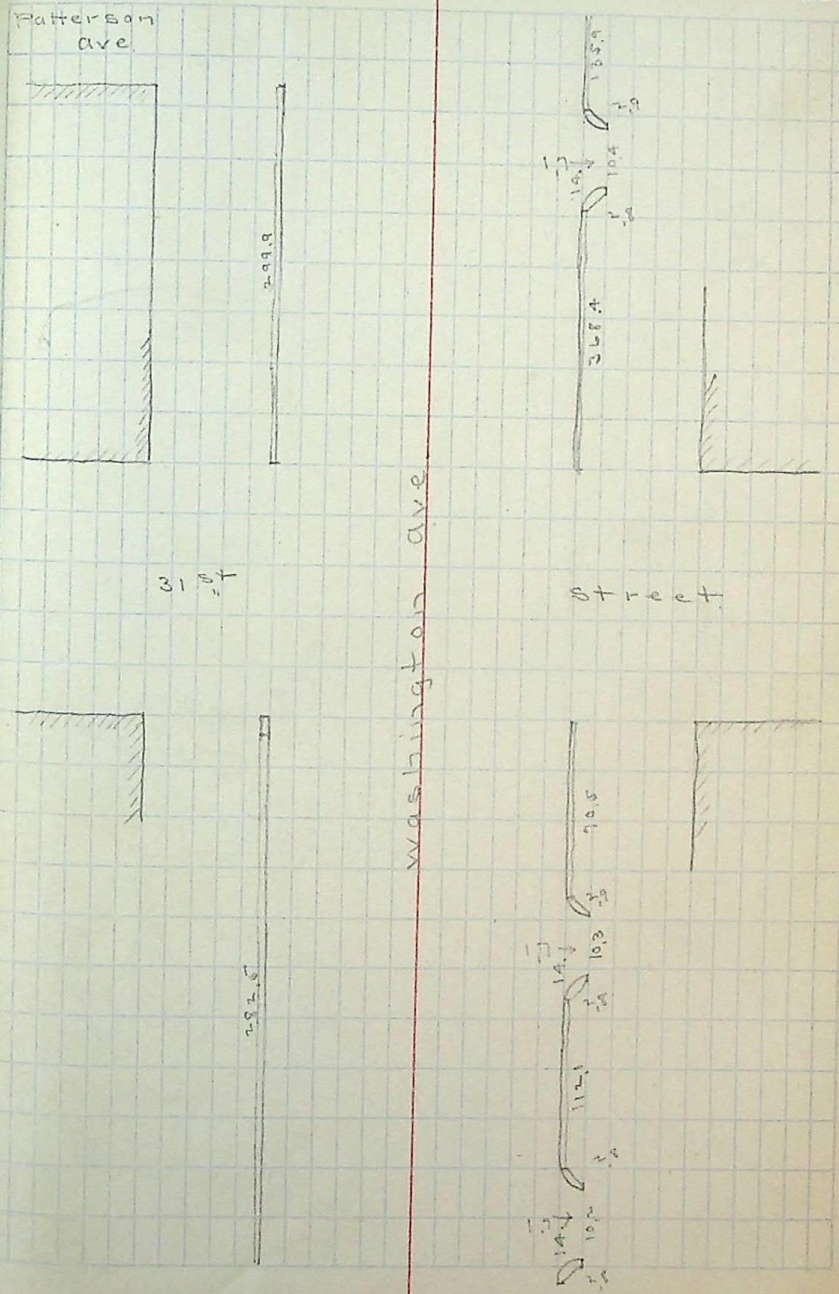
Patterson ave
31st
Washington Ave
Street
299.9
282.5
135.9
368.4
70.5
112.1