



19th

Washington Ave

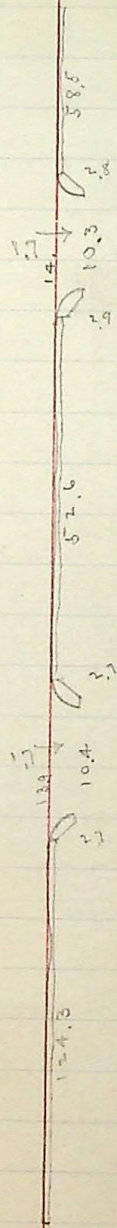


street

28th

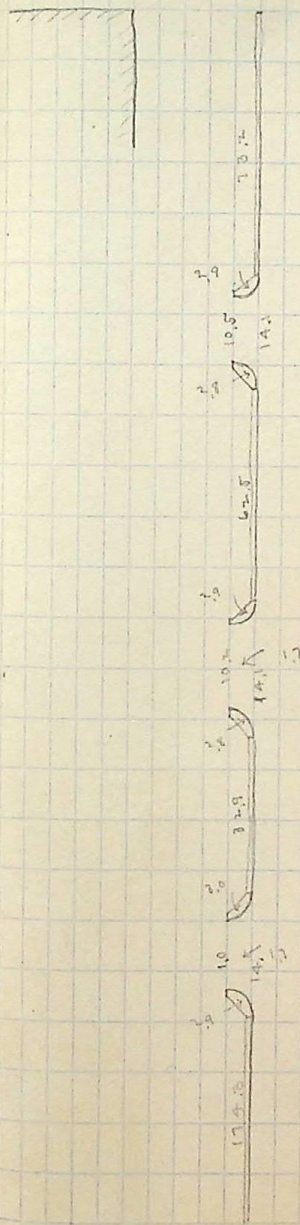

Washington Ave

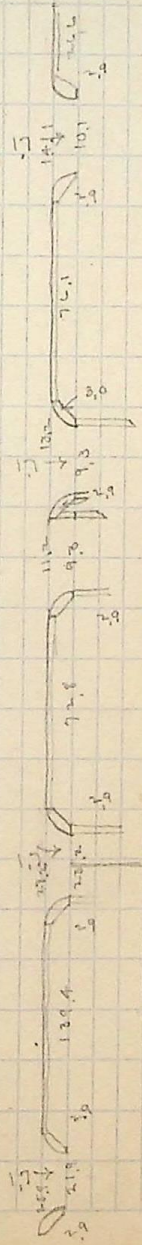

street