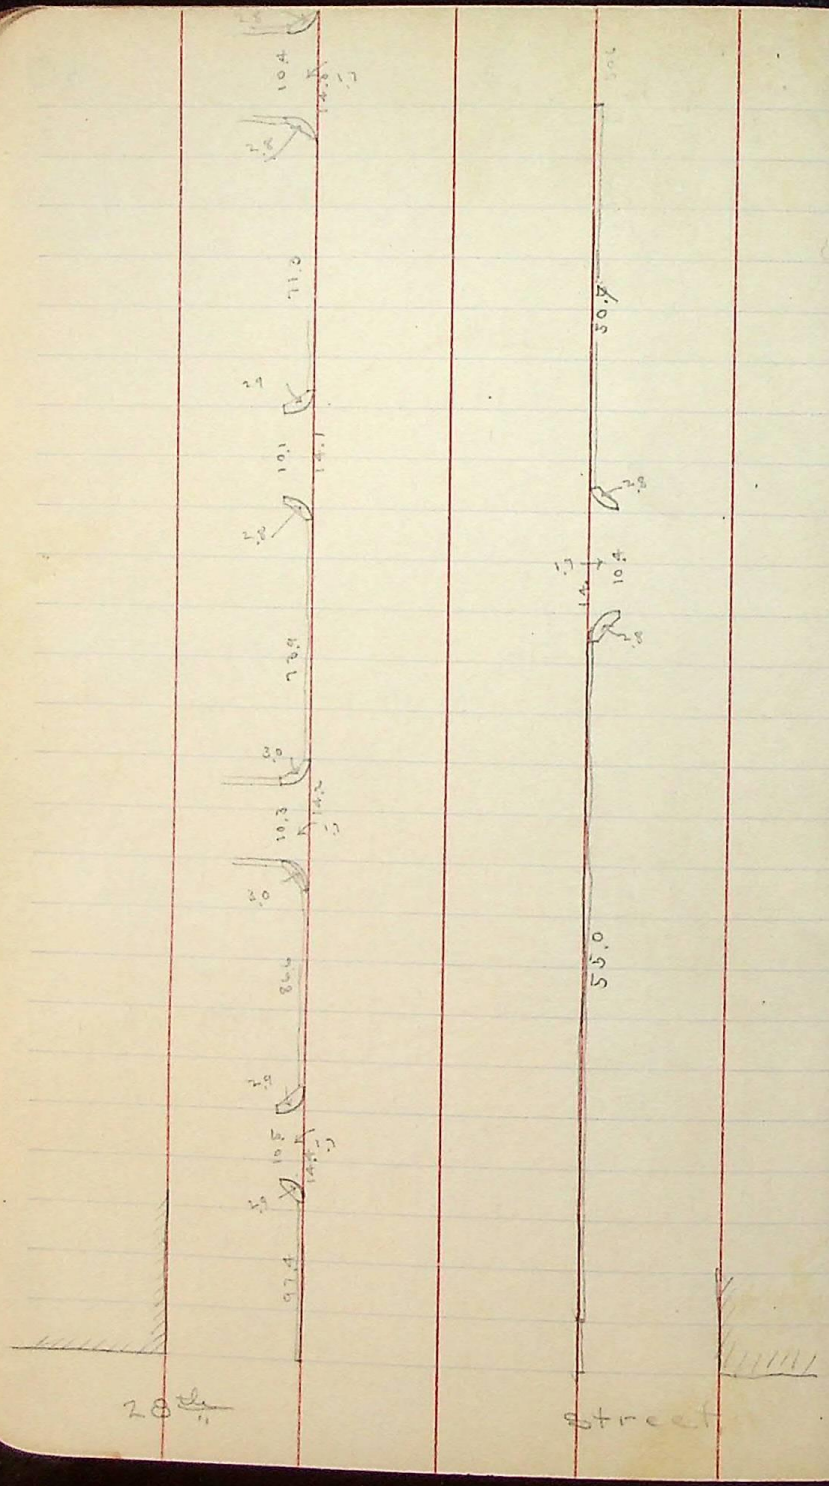
104
71.0
101
76.9
103
84.4
105
97.4
30.8
55.0
street
28th

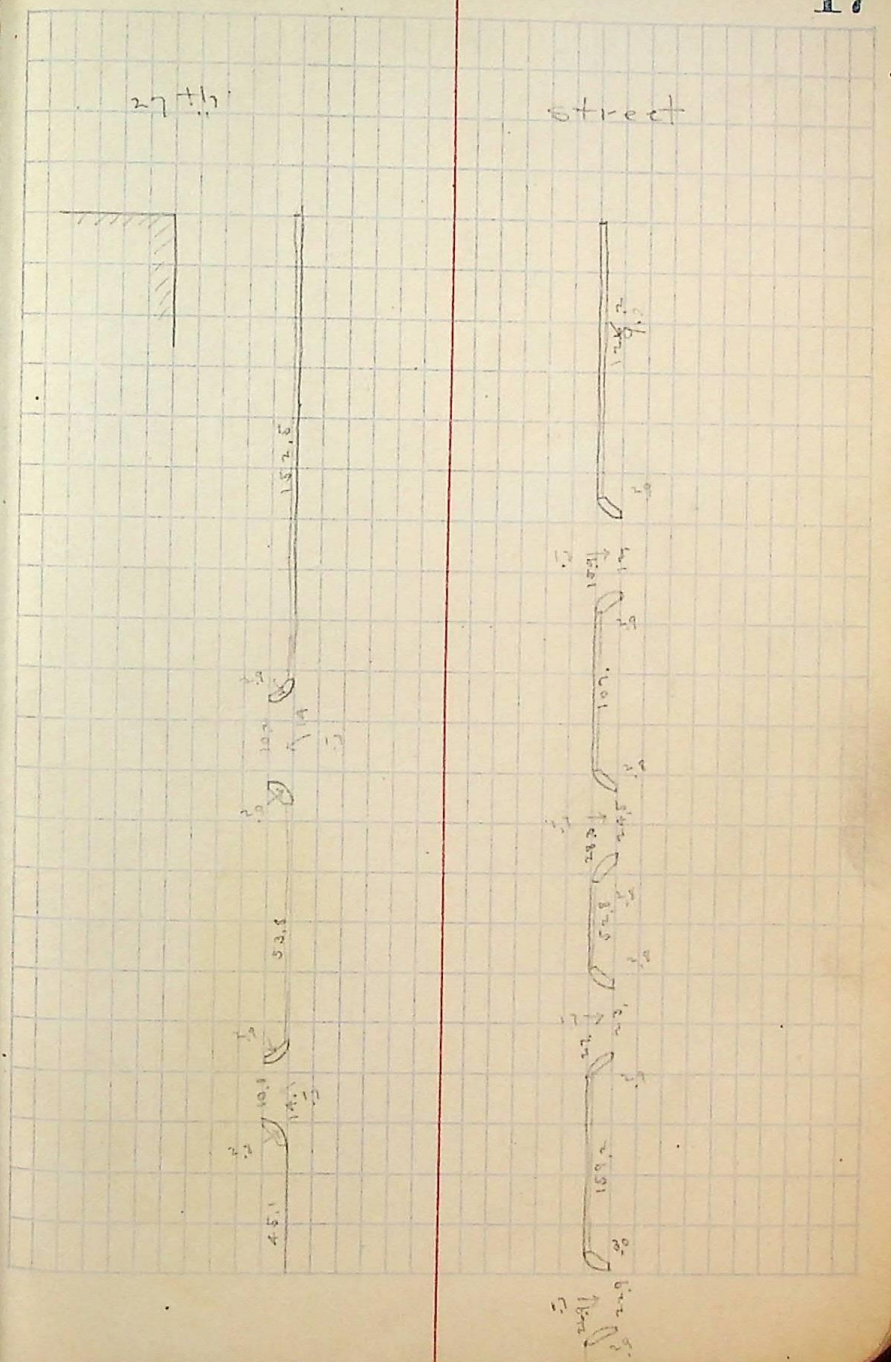
27th
152.6
53.4
45.1
street
107.
159.2