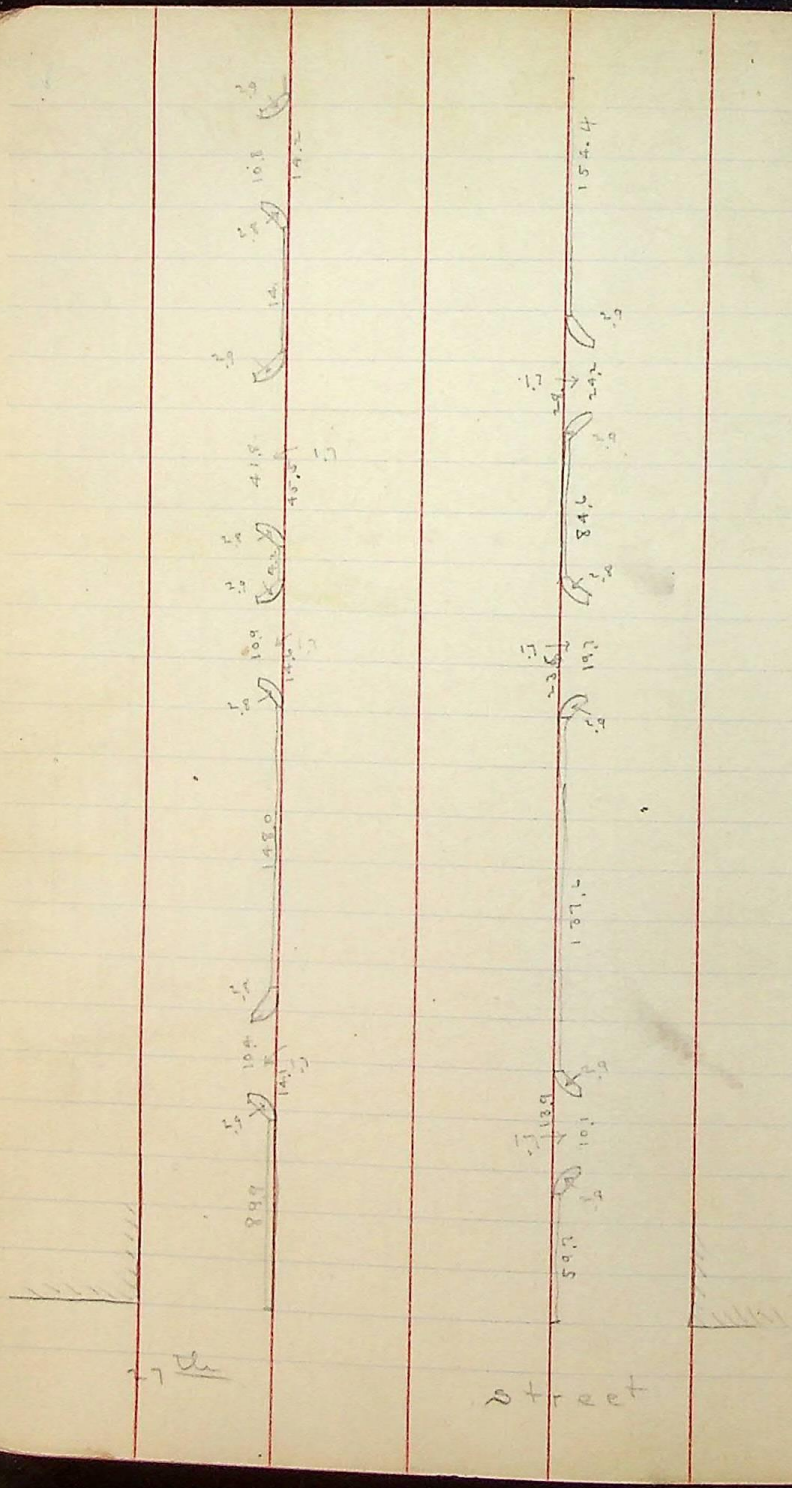
27th
Street

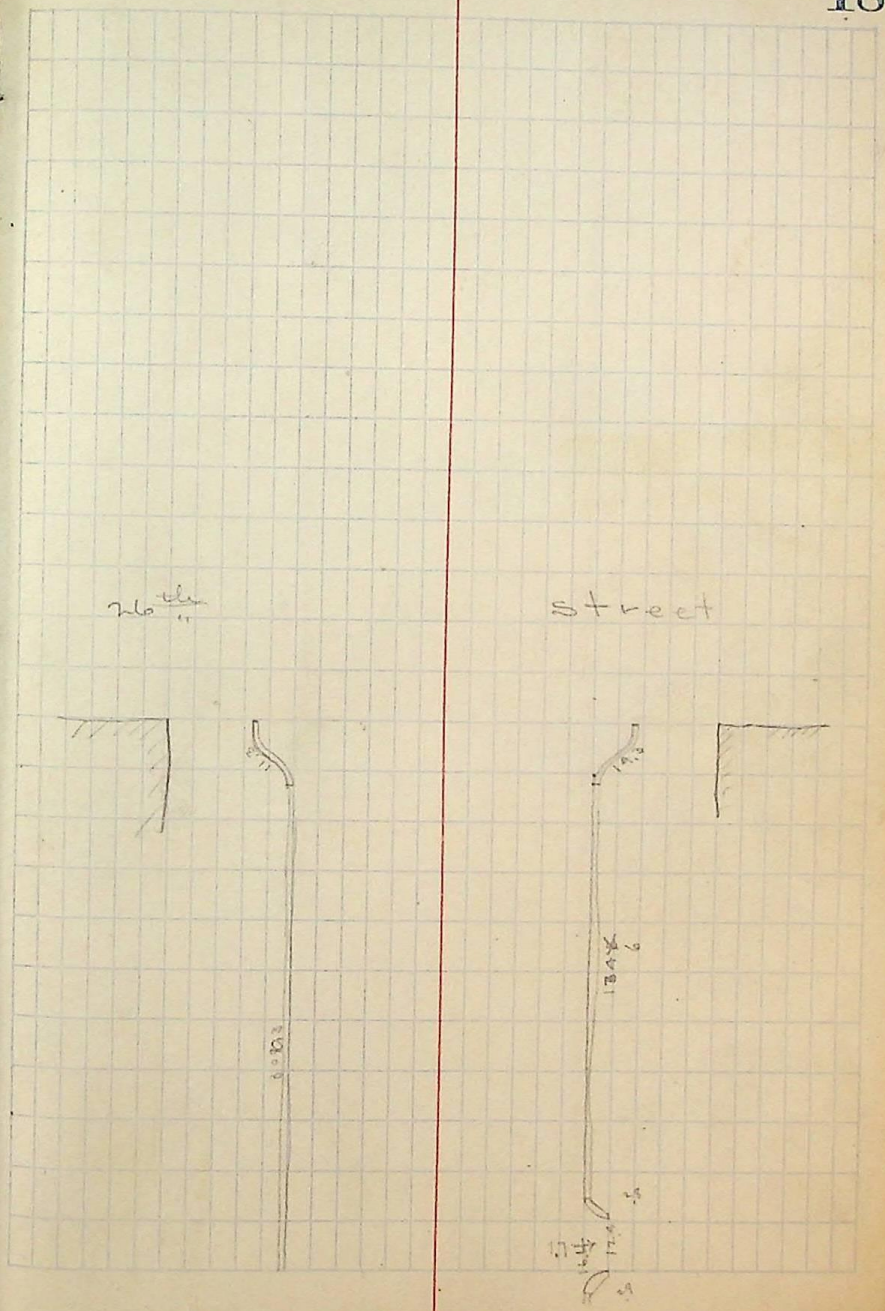
26th
Street