

30th St

Street



Grant Ave

Aug. 4 1905


Measurements of concrete curb & gutter
on Grant Ave 20th to 25th St.

G. H. P. Unit.

H. P. & chain

l l B "

} same to 10.00 am

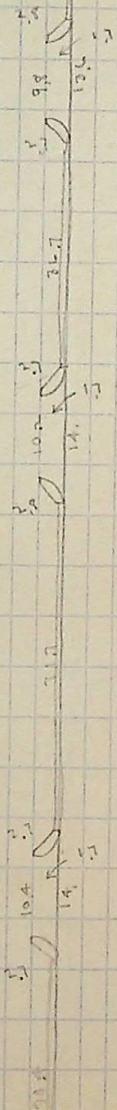

Grant Ave

