28th

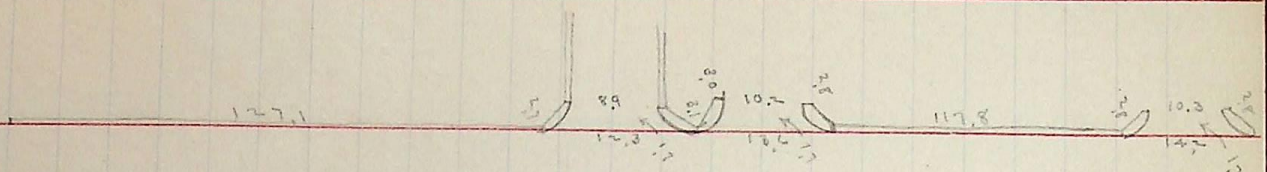

grant ave

stockton

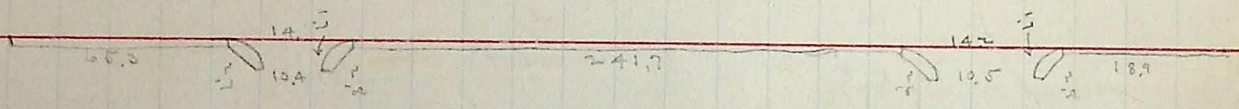

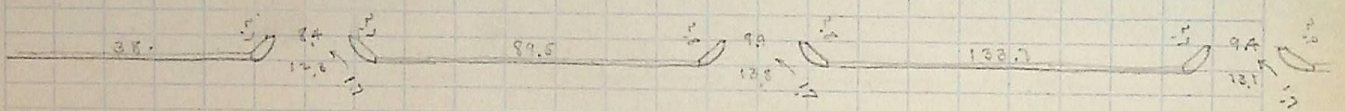
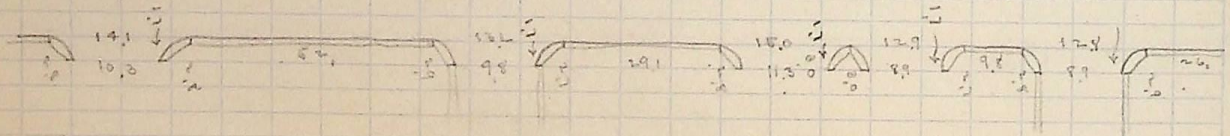
grant ave