


27 #


Grant Ave

Street

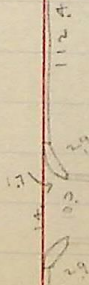

252.3

2

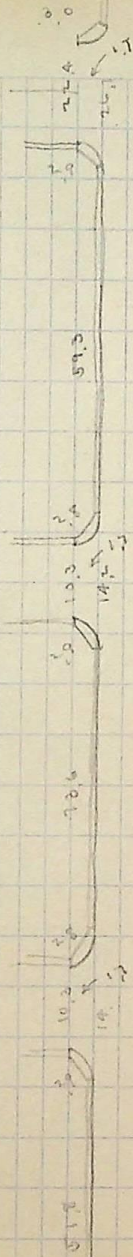

Grant Ave

