



26#

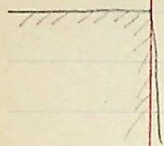


72.1
105.2
141.7
161.5
231.3

Grant Ave.

Street

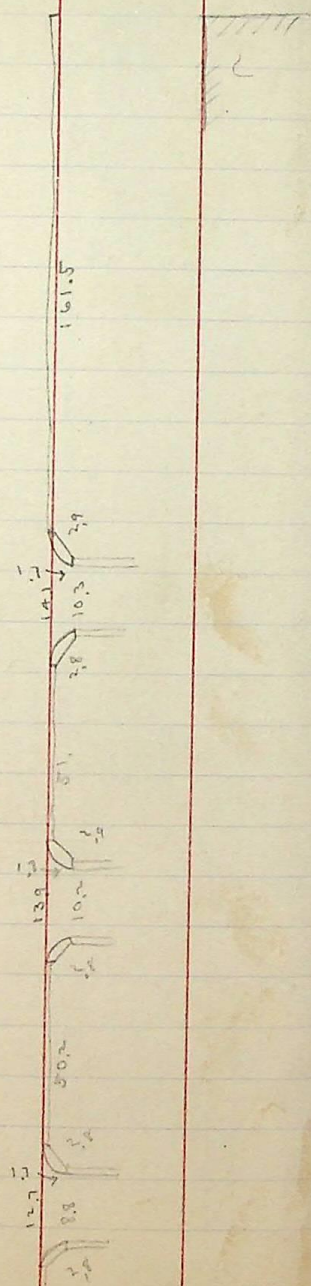


26#

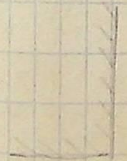

Grant Ave.

Street

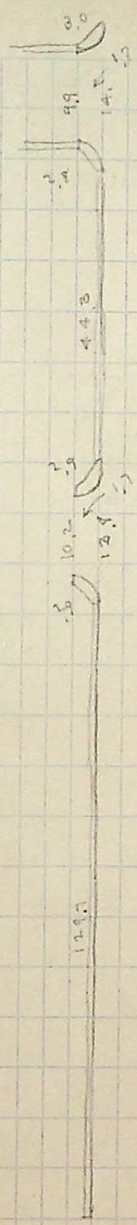

155.9

24