


Adams Ave.

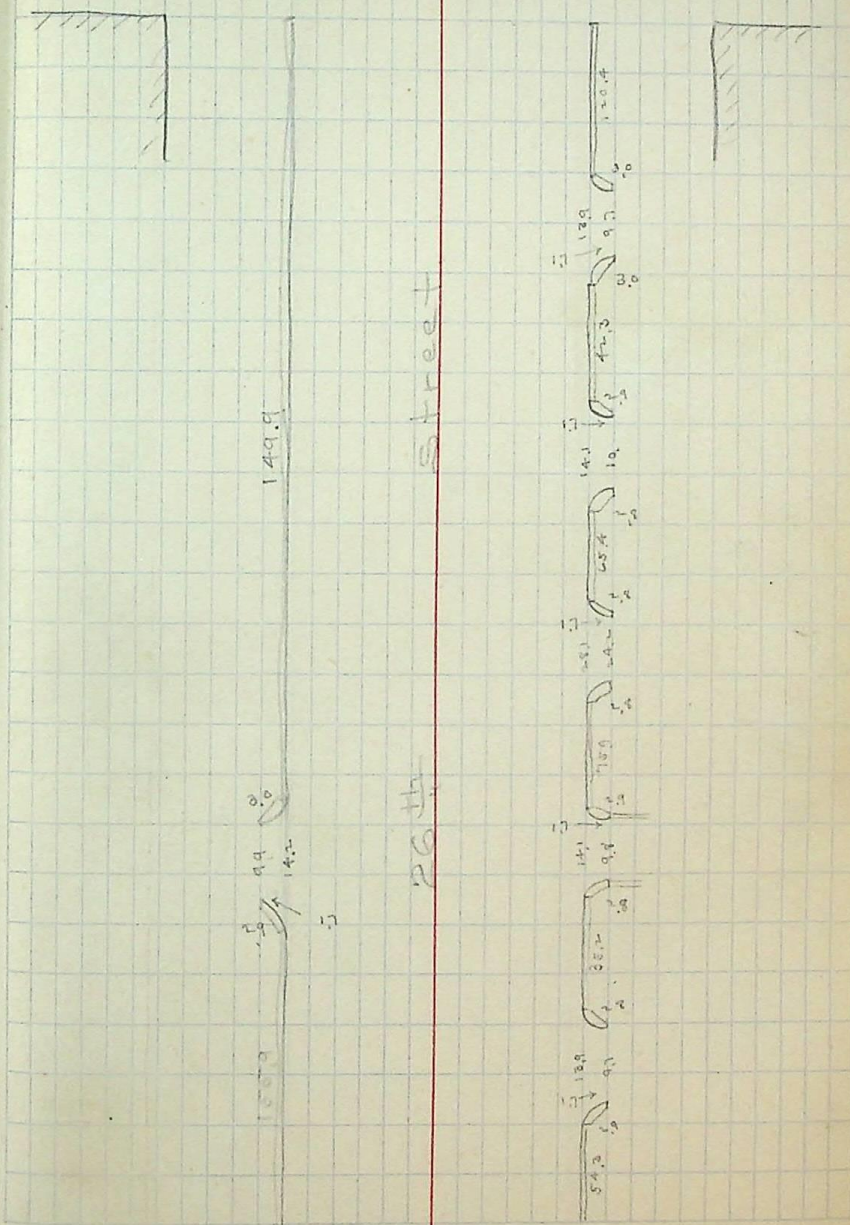

150.0
126.0
102.0
143.0

Street

26th

Washington Ave

Aug 4 1965

Measurements of concrete bank gutter
on north side of Washington Ave.
from 26th Street to 20th Street.

126.0

102.0

143.0

150.0

132.0

41.0

109.4

109.4

100.0

149.9










