


Adams

6477

26th

Street

119.9

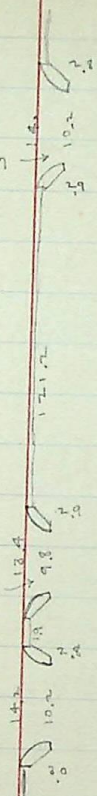

Ave

Jefferson Ave.

27

26th

Street

90.7

