


adams Ave

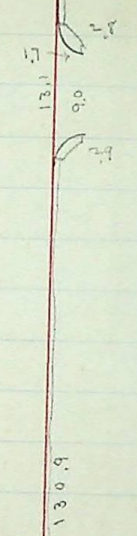


street

28th

Aug. 4, 1905

Measurements of concrete curb & gutter
adams Ave. 28th St. to 26th St.

Q. H. P. Inst. }
H. B. S. Rod } 2 P.M. - 4 P.M.
G. B. Chain }

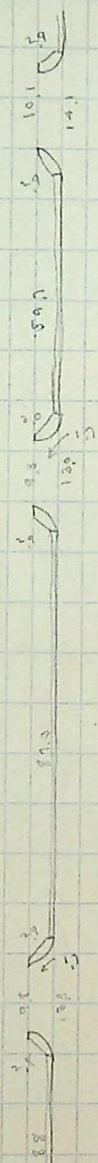

adams Ave

