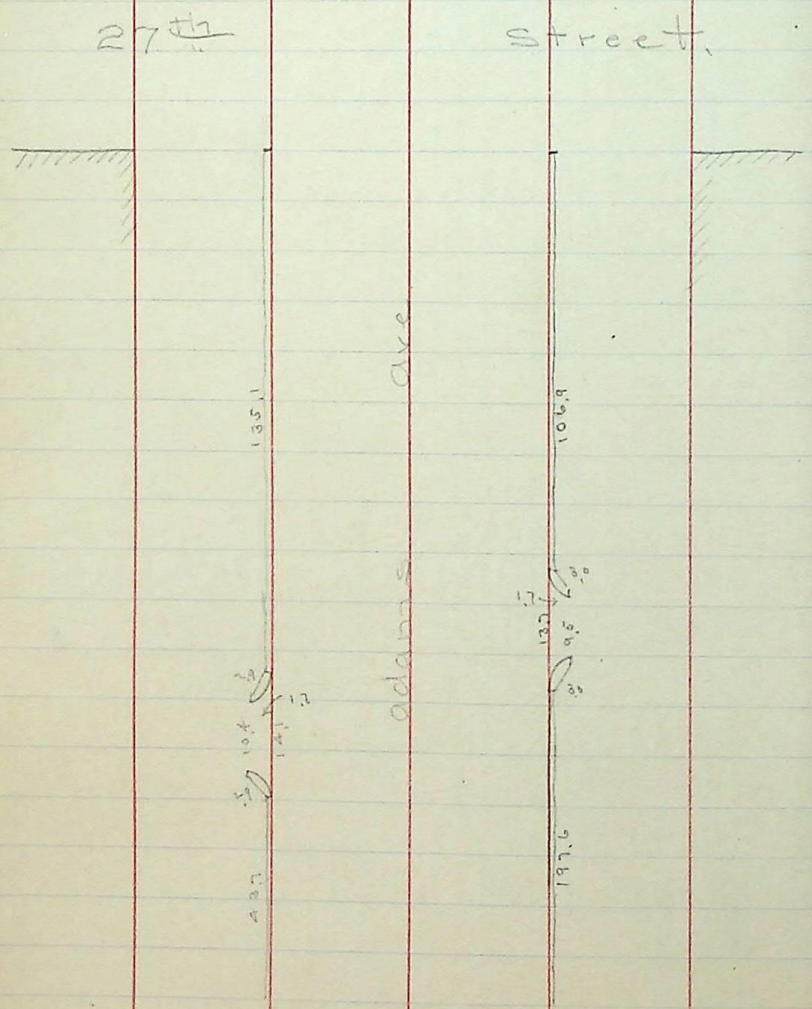
27th
Street.
adams ave
135.1
106.9
197.6

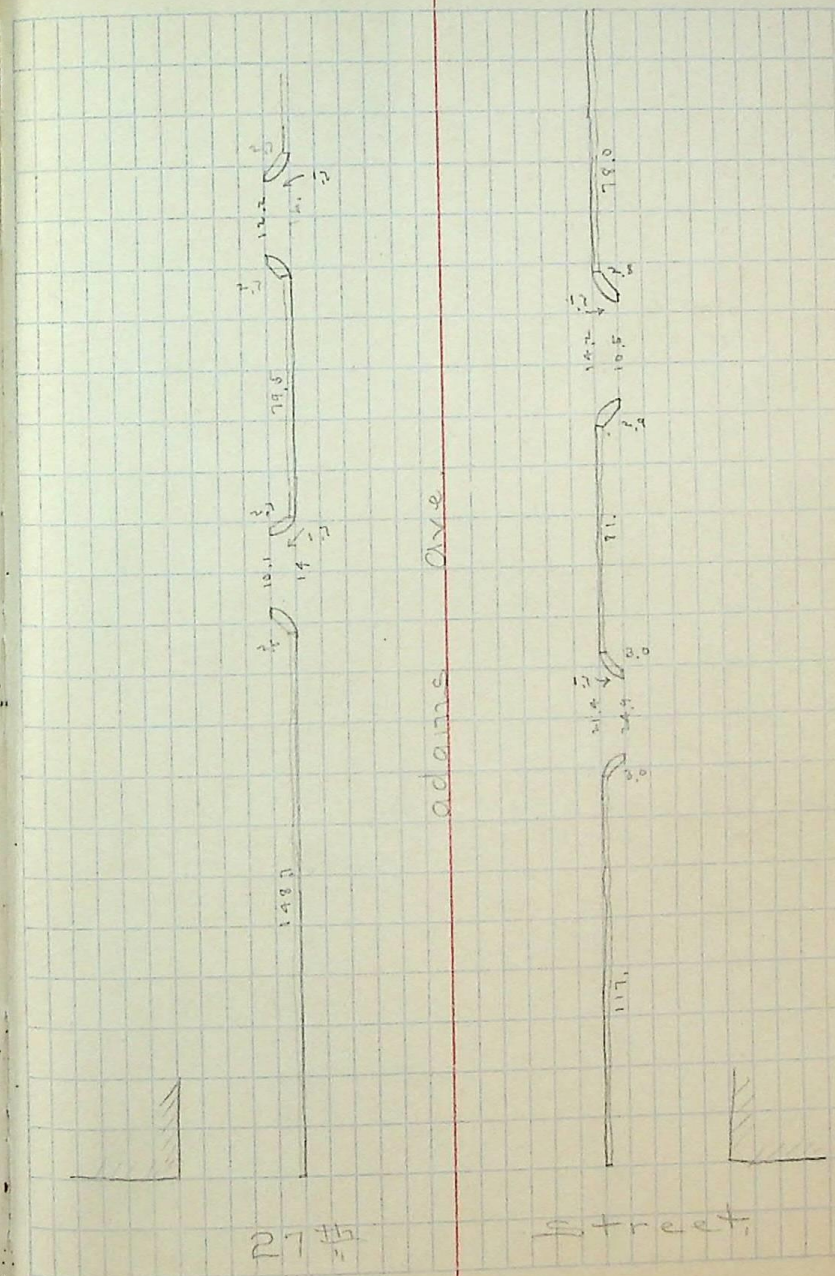
adams ave
148.7
79.5
78.0
117.
27th
Street.