

Madison Ave

25th St

Street

Aug. 5 1905


Measurements of concrete curbs cutters on
Madison Ave. 25th St. to 24th St.

G. H. P. Int.

H. B. S. chain

L. B. P. chain

} same eq am

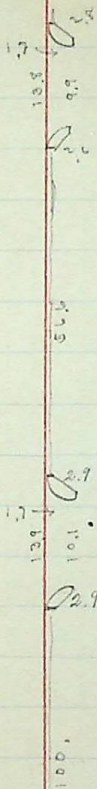

BASE

Ave

Madison

204

