


Wheelwright  
Washington Ave

Washington Ave

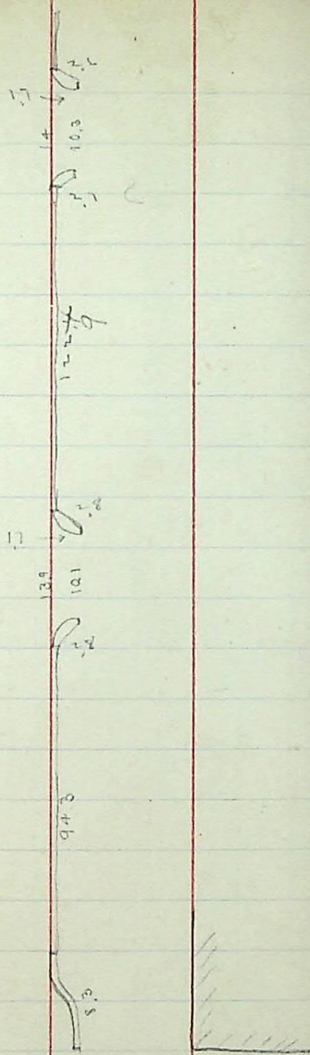

22<sup>nd</sup> Street

Aug. 5<sup>th</sup> 1905

Measurements of concrete curb, gutter  
on Washington Ave to Bridge  
of N. P. Int.

H. B. S. Chan } 3 P.m. to 4.00 P.m. Aug 5  
L. S. B. " } 10 a.m. to 11.30 a.m. " 7

Wheelwright

Washington Ave

