



WASHBURN AVE

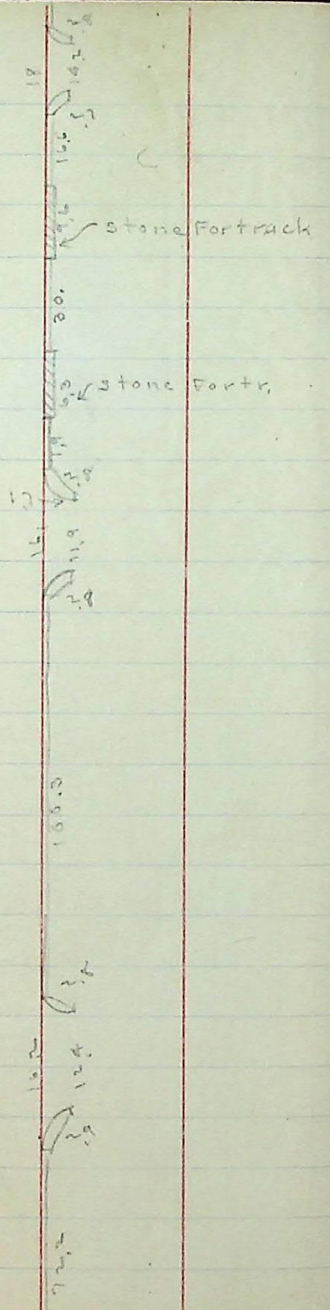

Ogden River Bridge

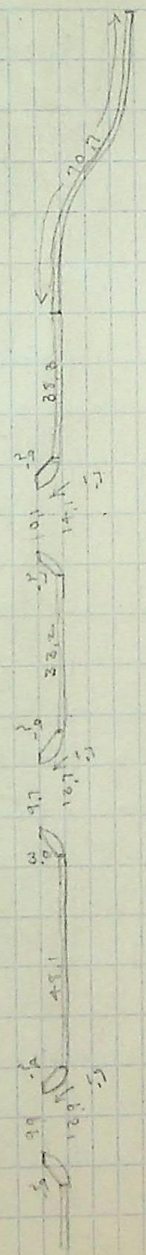

WASHBURN AVE

