



SOS + Gravelly Grd.

Total length 6244 ft
 drive ways 747 "

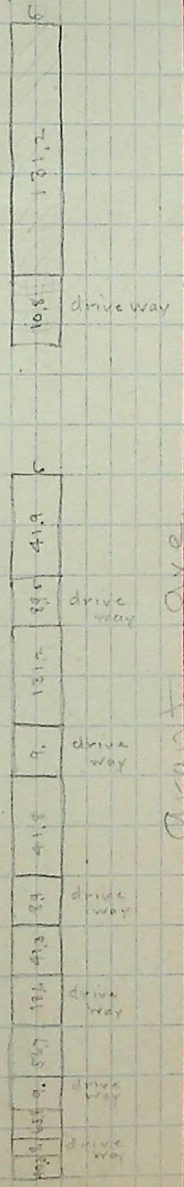

Gravel Ave

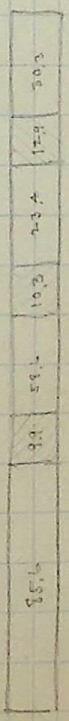

Total length 231 ft
 drive ways 231 "