


Madison Ave.

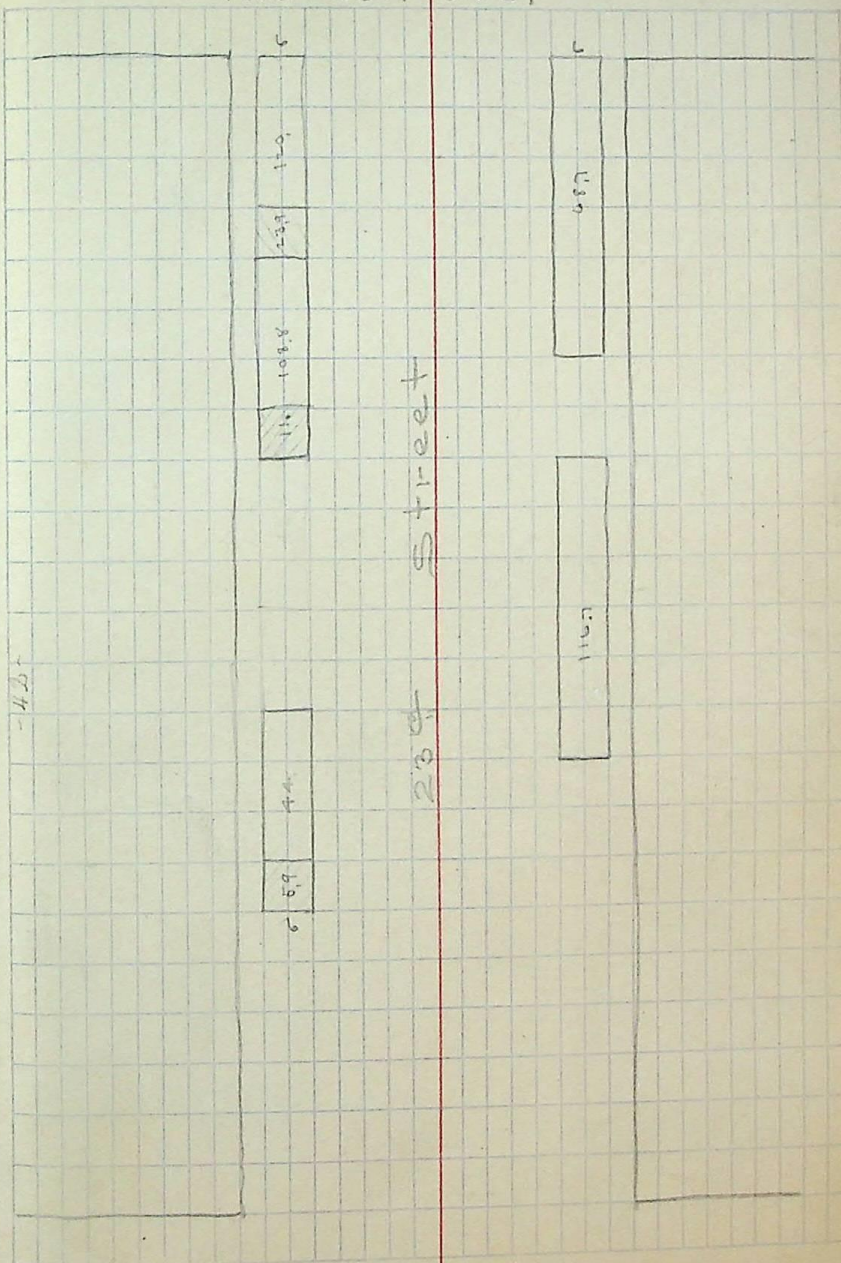

23rd Street

Jefferson Ave.