
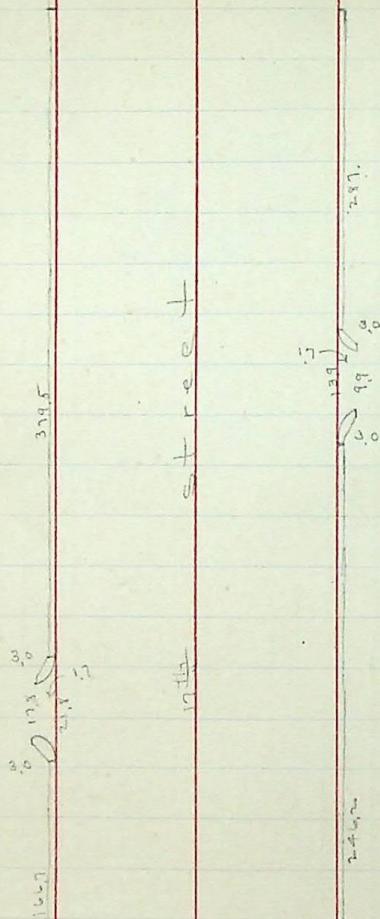


Cross Street

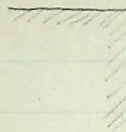



washington  
ave.  
Aug. 14 1905

Measurements of finished concrete curb &  
gutter on 17th St.

H.B.B. } same to man.  
L.B.B. }

Street

54

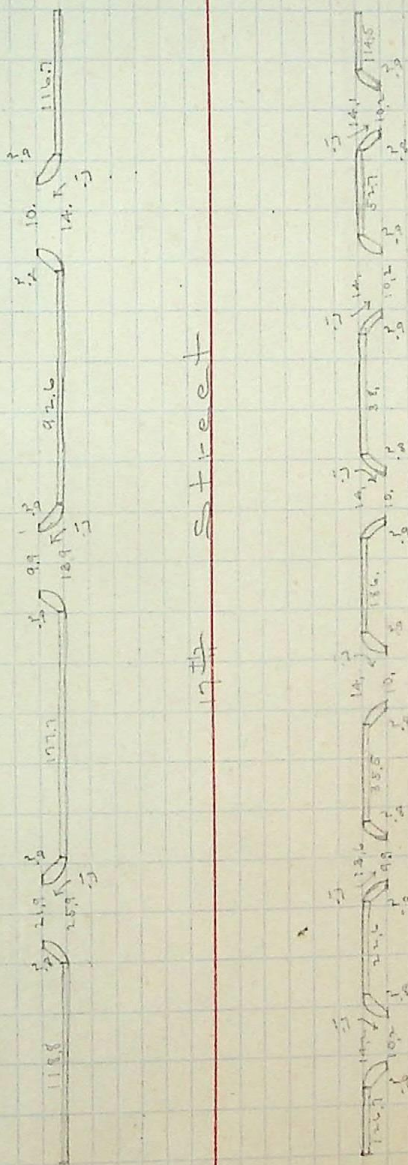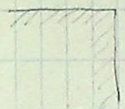

Cross Street