Aug. 18 1905

Measurement of finished concrete curb & gutter on Lincoln from 23rd to 30th St.
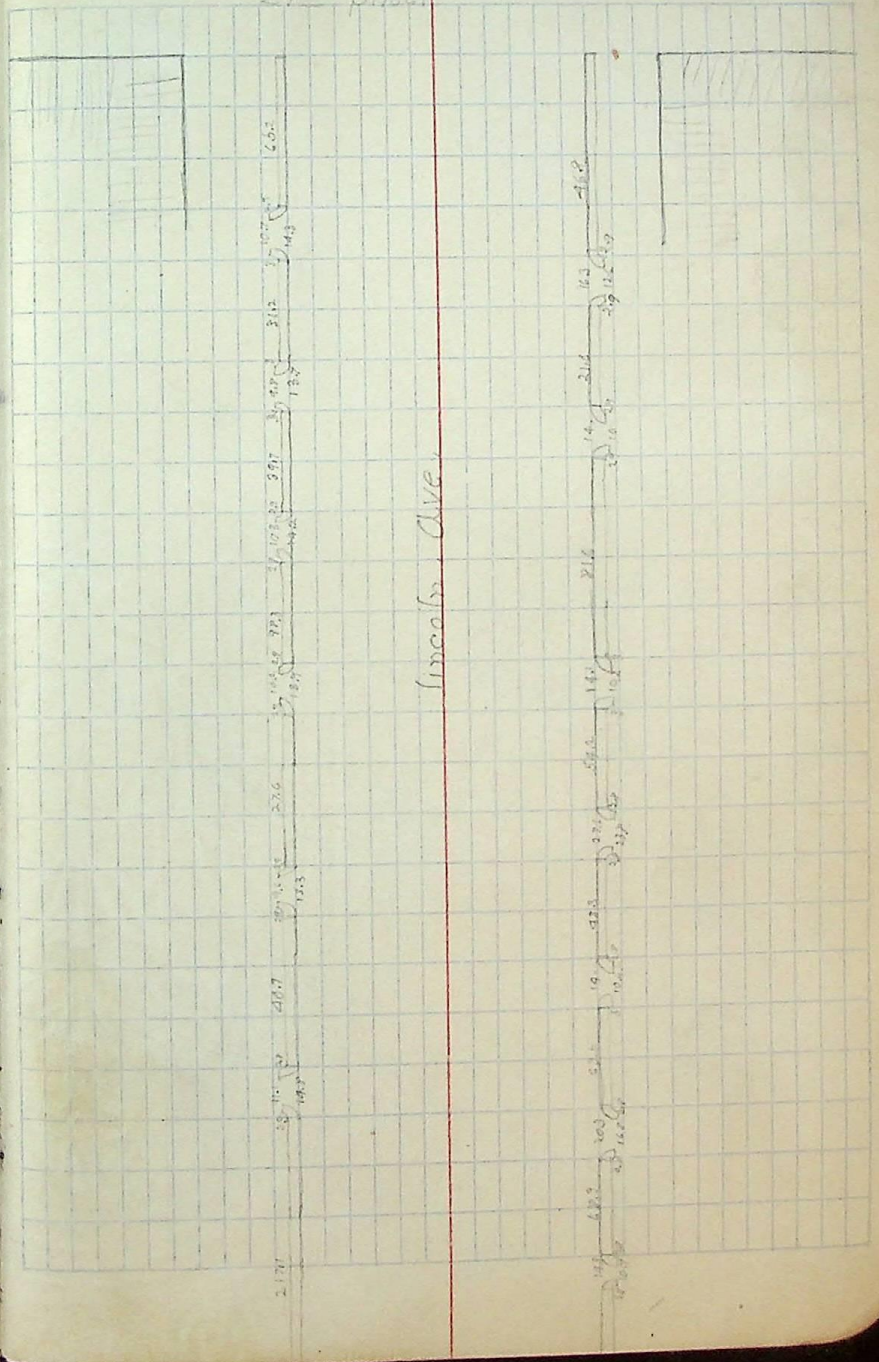
H. B. S. } 8 a.m. to 11 a.m.
G. C. B. }