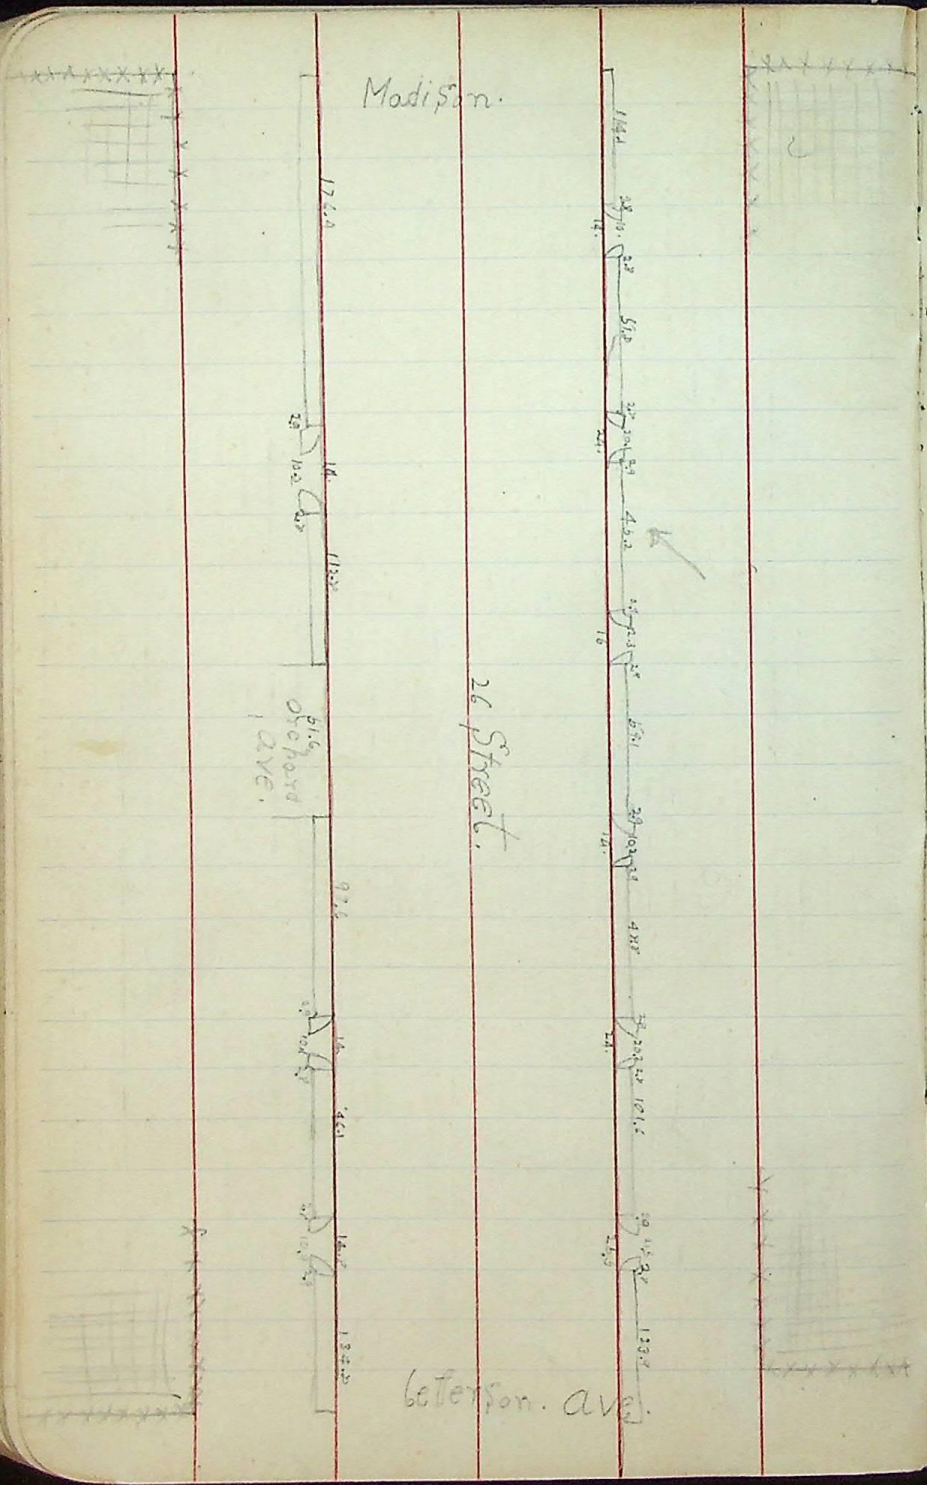
Madison.
26 Street.

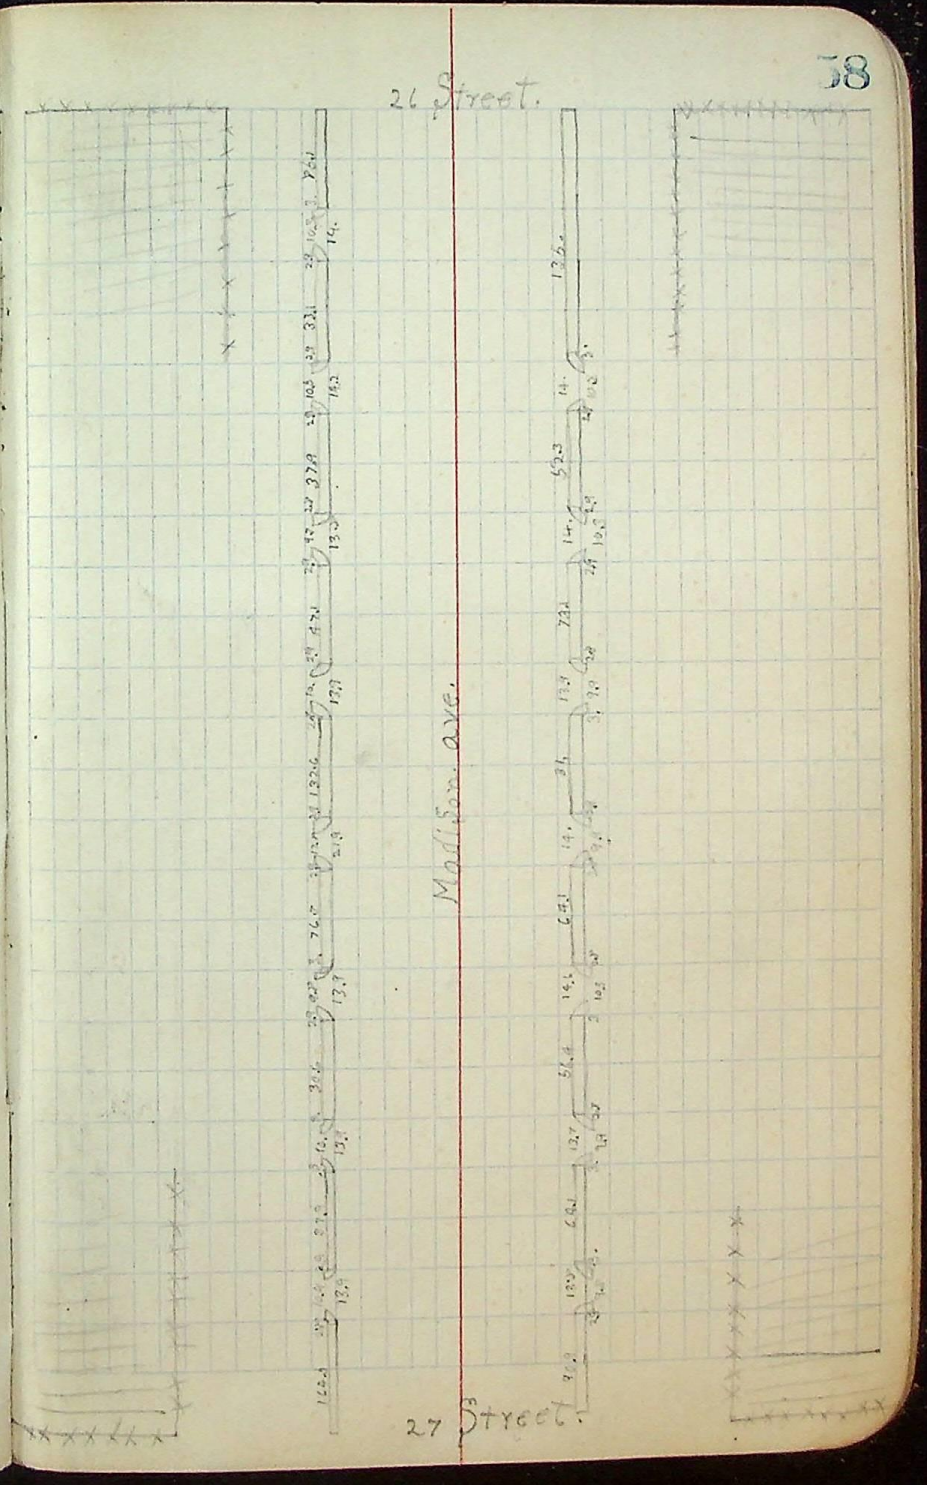
26 Street.
Madison. ave.
27 Street.