

25 Street.


XXXXXX

Street side



Madison Ave

26 Street

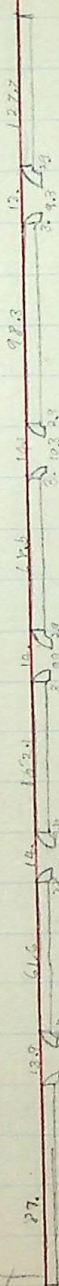

East side

XXXXXX

XXXXXX